

MISSISSIPPI DEPARTMENT OF NATURAL RESOURCES

Bureau of Land and Water Resources

Southport Mall

P.O. Box 10631

Jackson, Mississippi 39209

WATER WELL DRILLERS LOG

Jackson
N605

4

8-4-83 19 Coast Water Well Sew. Jackson
date well completed firm name county well located

LANDOWNER William B. Rudy
Rt 3 - Box 205 B
Ocean Springs, Miss.
(mailing address) 35564

description of formations encountered	from	to
Top soil	0	1'
White coarse sand	1'	25'
Blue Clay	25'	40'
White coarse sand	40'	69'
Blue Clay & streak of sand	69'	124'

WELL LOCATION:
sec. 10 T. 8 N. R. 8 E
3 miles SE of OCEAN SPRINGS
(distance) (direction) (nearest town)

WELL PURPOSE: Home
(home, irrigation, municipal, industrial)

WELL COMPLETION DATA:
(1) diameter (inches) 4" x 2"
(2) total depth (feet) 510'
(3) static water level (feet) 60' below top of ground.
(4) casing PVC, 490' (material) (depth)
4" x 2" if telescope see back. (size)
(5) screen 20', 490' (length) (depth to top)
4" x 2", PVC (size) (material)
(6) pump 2 h.p., 45 (hp) (yield gpm)
Elect. (type power)
(7) electric log No (yes or no)
(organization running log)

Gray coarse sand & gravel	124'	198'
Blue Clay	198'	385'
Gray med sand	385'	408'
Blue Clay	408'	475'
Gray coarse sand	475'	510'

(8) how well bottom plugged Back Wash Valve

DRILLERS REMARKS:


DEPT. OF NATURAL RESOURCES
BUREAU OF LAND & WATER RESOURCES

SEP 21 1983

RECEIVED

If well telescopes please sketch and show depths.

GROUND LEVEL

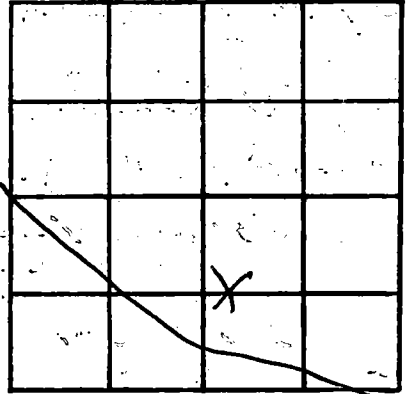

SECTION 20

Please indicate well location X.

ADDITIONAL INFORMATION

If more than one screen, show locations of each on sketch.