

MISSISSIPPI DEPARTMENT OF NATURAL RESOURCES

Bureau of Land and Water Resources

Southport Mall

P.O. Box 10631

# 5

Jackson, Mississippi 39209

WATER WELL DRILLERS LOG

Jackson  
N606

10-23 date well completed 84 Coast Water Well Sew. firm name Jackson county well located

LANDOWNER	description of formations encountered	from	to
<u>Ngil Rafferty</u> <u>Box 3 - Box 138 P.</u> <u>Ocean Springs, Miss.</u> (mailing address) <u>39564</u>	<u>Med. Sandy Top soil</u>	<u>0</u>	<u>22'</u>
	<u>Gray Clay</u>	<u>22'</u>	<u>33'</u>
	<u>Coarse sand Gray</u>	<u>33'</u>	<u>69'</u>
	<u>Blue Clay</u>	<u>69'</u>	<u>193'</u>
	<u>Blue Clay</u>	<u>193'</u>	<u>400'</u>
	<u>Fine Med. Sand</u>	<u>400'</u>	<u>420'</u>

WELL LOCATION:  
sec. 4 T. 8 S. R. 8 W.  
1 1/2 miles SE of OCEAN SPRINGS  
(distance) (direction) (nearest town)

WELL PURPOSE: None  
(home, irrigation, municipal, industrial)


- WELL COMPLETION DATA:
- (1) diameter (inches) 2"
  - (2) total depth (feet) 499'
  - (3) static water level (feet) 72 below top of ground.
  - (4) casing PVC 484'  
(material) (depth)
  - 2" if telescope see back.  
(size)
  - (5) screen 15' 484'  
(length) (depth to top)
  - 2" PVC  
(size) (material)
  - (6) pump 2hp 10  
(HP) (yield gpm)
  - (type power)
  - (7) electric log No  
(yes or no)
  - (organization running log)
  - (8) How well bottom plugged?  
back wash valve

51 x 2" PVC Tail Pipe

DRILLERS REMARKS: 1-8-85  
EFW

If well telescopes please sketch and show depths.

GROUND LEVEL

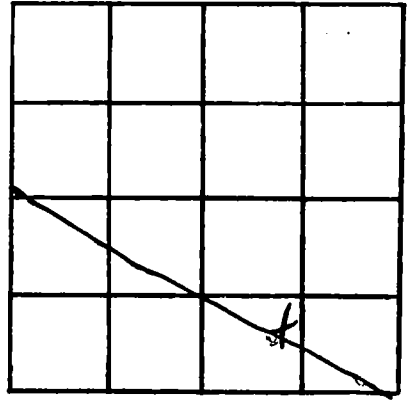

SECTION 4

Please indicate well location X.

ADDITIONAL INFORMATION

If more than one screen,  
show locations of each on sketch.