

MISSISSIPPI DEPARTMENT OF NATURAL RESOURCES

Bureau of Land and Water Resources

Southport Mall

P.O. Box 10631

Jackson, Mississippi 39209

WATER WELL DRILLERS LOG

Jackson
N 677

6-13-86 19 Coast water well Jackson
 date well completed firm name county well located

LANDOWNER: C E Stovall
Bel Fountain Beach
Ocean Springs, ms
 (mailing address)

WELL LOCATION:
 1/2 sec 13 T. 8 N R. 8 E
4 miles SE of Ocean Springs
 (distance) (direction) (nearest town)

WELL PURPOSE: home
 (home, irrigation, municipal, industrial)

WELL COMPLETION DATA:

- (1) diameter (inches) 2"
- (2) total depth (feet) 540'
- (3) static water level (feet) 34 below above top of ground.
- (4) casing PUC 515'
 (material) (depth)
2" if telescope see back.
 (size)
- (5) screen 20' 515'
 (length) (depth to top)
2" PUC
 (size) (material)
- (6) pump 1 10
 (HP) (yield gpm)
Elect
 (type power)
- (7) electric log no
 (yes or no)
 (organization running log)
- (8) how well bottom plugged backwash valve


description of formations encountered	from	to
Top Soil	0	10
Blue Clay + Clam Shell	10	60
white Coarse Sand	60	80
Blue Clay + streak of Sand	80	112
Blue Clay	112	172
Blue Clay + streak of Sand	172	194
Gray Coarse Sand	194	229
Blue Clay	229	250
Blue Clay + Oyster Shell	250	455
Blue Clay	455	507
Gray Coarse Sand	507	540

DRILLERS REMARKS:
5'-0" PUC tail pipe

RECORDED
 AUG 11 1986
 Department of Natural Resources
 Bureau of Land and Water Management

If well telescopes please sketch and show depths.

GROUND LEVEL

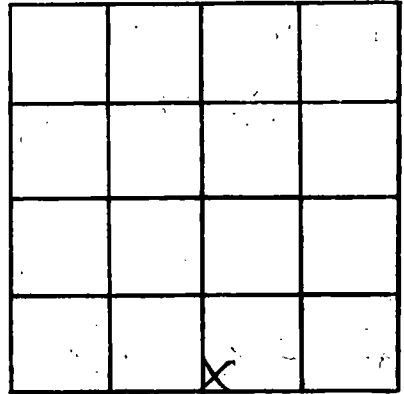

SECTION 13

Please indicate well location X.

ADDITIONAL INFORMATION

If more than one screen, show locations of each on sketch.