

JACKSON
N 679
10-21-80
10-21-

MISSISSIPPI
BOARD OF WATER COMMISSIONERS
416 North State Street
Jackson, Mississippi 39201

WATER WELL DRILLERS LOG

date well completed: 10-21-80
firm name: 580 Coast Water Well Sew. Inc.
county well located: Jackson

LANDOWNER: John M. Handley
3634 Ridgwell Rd.
Gautier, Miss 39533
(mailing address)

WELL LOCATION:
S 1/2 sec. 13 T 8 N R 8 W
7 miles SE of Ocean Springs
(distance) (direction) (nearest town)

WELL PURPOSE: Home
(home, irrigation, municipal, industrial)

WELL COMPLETION DATA:
(1) diameter (inches) 2"
(2) total depth (feet) 512'
(3) static water level (feet) 44' below top of ground.
(4) casing PVC, 502' (material) (depth)
3" (size) if telescope see back.
(5) screen 10' 502' (length) (depth to top)
3" (size) PVC (material)
(6) pump R.P. 8 (HP) (yield gpm)
Elect. (type power)
(7) electric log No. (yes or no)
N/A. (organization running log)
(8) how well bottom plugged Back Wash Valve

description of formations encountered	from	to
Top soil	0	1'
White coarse sand	1'	47'
Blue Clay & Chert shell	47'	66'
White coarse sand	66'	112'
blue clay	112'	189'
gray fine sand	189'	214'
Blue Clay & Chert shell	214'	405'
Blue Clay & Shale	405'	471'
gray coarse sand	471'	512'

DEPT. OF NATURAL RESOURCES
BUREAU OF LAND & WATER RESOURCES


APR - 6 1981

RECEIVED

DRILLERS REMARKS:

If well telescopes please sketch and show depths.

GROUND LEVEL

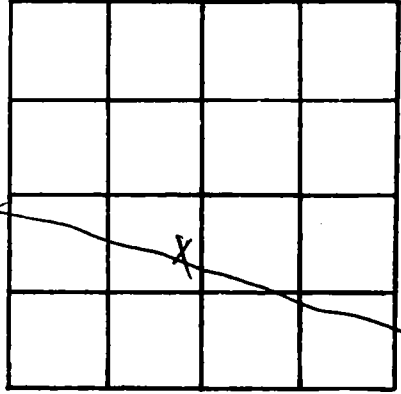

SECTION 13

Please indicate well location X.

ADDITIONAL INFORMATION

Lined area for additional information.

If more than one screen, show locations of each on sketch.