

MISSISSIPPI DEPARTMENT OF NATURAL RESOURCES

Bureau of Land and Water Resources

Southport Mall

P.O. Box 10631

Jackson, Mississippi 39209

WATER WELL DRILLERS LOG

Jackson
N 681
4-15-81



4-15-81 date well completed
Coast Water Well Services firm name
Jackson county well located

LANDOWNER: Allen J. Ables
4836 Crestwood Court
Dunbar, Miss.
(mailing address) 39213

description of formations encountered	from	to
Top soil	0	5'

WELL LOCATION:
SESE sec. 1 T. 8 N. R. 8 E
S W
5 miles SE of Deer Park
(distance) (direction) (nearest town)

White coarse sand	5'	76'
Blue Clay and streak of sand	76'	130'

WELL PURPOSE: None
(home, irrigation, municipal, industrial)

Blue clay	130'	150'
Blue Clay & streak of sand	150'	200'

WELL COMPLETION DATA:

(1) diameter (inches) 2"
(2) total depth (feet) 484'
(3) static water level (feet) 44' below top of ground.
(4) casing PVC 474'
(material) (depth)
2" (size) if telescope see back.
(5) screen 10' 474'
(length) (depth to top)
2" PVC
(size) (material)
(6) pump 1 h.p. 9-
(HP) (yield gpm)
Elect.
(type power)
(7) electric log No.
(yes or no)
(organization running log)

Blue Clay	200'	305'
Blue Clay and clay shale	305'	350'
Blue Clay and streak of sand	350'	370'
Blue Clay	370'	446'
Gray coarse sand	446'	484'

(8) How well bottom plugged:
Back Wash Valve

DRILLERS REMARKS:


DEPT. OF NATURAL RESOURCES
BUREAU OF LAND & WATER RESOURCES

JUN 2 - 1981

RECEIVED

If well telescopes please sketch and show depths.

GROUND LEVEL

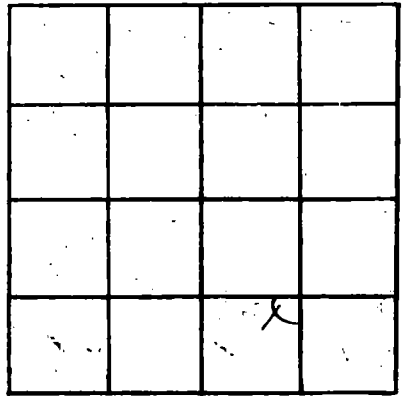

SECTION /

Please indicate well location X.

ADDITIONAL INFORMATION

If more than one screen,
show locations of each on sketch.