

**MISSISSIPPI DEPARTMENT OF ENVIRONMENTAL QUALITY**  
Office of Land and Water Resources

P. O. Box 10631  
Jackson, MS 39289-0631  
**WATER WELL DRILLERS LOG**

COUNTY WELL LOCATED <i>Jackson</i>	
WELL NUMBER <i>N693</i>	CODED
DATE WELL COMPLETED <i>1-20-95</i>	

PERMIT NUMBER
NAME OF DRILLING FIRM <i>Coast Water Well Service</i>

NAME & MAILING ADDRESS OF LANDOWNER <i>Bobbie Crudup</i> <i>Bayou Pine Drive</i> <i>Ocean Springs, Ms</i>			
WELL LOCATION <i>NW</i>	SEC <i>13</i>	TOWNSHIP <i>7<sup>S</sup></i>	RANGE <i>9<sup>W</sup></i>
DISTANCE <i>2</i> Miles	DIRECTION <i>NW</i>	NEAREST TOWN <i>Ocean Springs</i>	
OTHER LANDMARK			
WELL PURPOSE <input checked="" type="checkbox"/> Home, <input type="checkbox"/> Irrigation, <input type="checkbox"/> Municipal, <input type="checkbox"/> Industrial, <input type="checkbox"/> Fish Pond, etc.			

<b>PUMP DATA</b>		
PUMP TYPE (Circle One): Submersible, Turbine, <input checked="" type="radio"/> <i>J&amp;I</i> <input type="radio"/> Flowing Well, Other (Describe) _____		
POWER TYPE (Circle One): <input checked="" type="radio"/> <i>Electric</i> <input type="radio"/> Tractor, <input type="radio"/> Diesel, <input type="radio"/> Gasoline, <input type="radio"/> Butane, Other (Describe) _____ H/P <i>2</i>		
Pump Capacity (GPM) <i>12</i>	No. of Stages <i>3</i>	Setting Depth _____ FT.
PUMP TEST Well yielded _____ GPM with a drawdown of _____ ft. after _____ hours of pumping		

<b>WELL DATA</b>		
Well Depth <i>470'</i>	Casing Diameter (In.) <i>2"</i>	Casing Length (Ft.) <i>460'</i>
Type of Casing <i>PVC</i>	Hole Depth <i>470'</i>	Depth to Static Water Level <i>85'</i>
TYPE OF COMPLETION: (Circle One or More): <input checked="" type="checkbox"/> Gravel Packed, <input type="checkbox"/> Underreamed, <input type="checkbox"/> Telescoped, <input checked="" type="checkbox"/> <i>Natural Development</i> , <input type="checkbox"/> Open Hole, <input type="checkbox"/> Other (Describe) _____		
WELL GROUTED TO A DEPTH OF <i>20</i> FEET Type Grout (circle one): Cement, <input checked="" type="checkbox"/> <i>Bentonite</i> or Mix		

<b>LOG DATA</b>	
TYPE OF LOG RUN (Circle One): Electric, Gamma Ray, Density, Sonic, Neutron, <input checked="" type="radio"/> <i>No Log Run</i> , Other (Describe) _____	
Name of Organization Running Log	

<b>SCREEN DATA</b>		
Diameter - Inches <i>2"</i>	Length - Feet <i>10'</i>	Slot Size - Inches <i>.008</i>
Screen Type <i>PVC</i>	Depth to Bottom - Feet <i>470'</i>	

<b>GEOLOGIC DATA (Office Use Only)</b>			
Surface Elev.	Geologic Unit	Unit Thickness	Depth to Top
Subs. SWL	Date	Analysis	Aquifer Test
Driller's Remarks			
Top of Lap Pipe or Reduction in Casing			
FEET		IF TELESCOPED OR MORE THAN ONE SCREEN: USE BACK PAGE	

DESCRIPTION OF FORMATIONS ENCOUNTERED	FROM	TO	FORMATIONS (Continued)	FROM	TO
<i>Top Soil</i>	<i>0</i>	<i>2</i>			
<i>Quartz &amp; gray clay</i>	<i>2</i>	<i>25</i>			
<i>Coarse sand</i>	<i>25</i>	<i>55</i>			
<i>Blue clay thick sand</i>	<i>55</i>	<i>408</i>			
<i>Fine - coarse sand</i>	<i>408</i>	<i>470</i>			

**RECEIVED**


**FEB 14 1995**

Dept. of Environmental Quality  
Office of Land & Water Resources

IF MORE SPACE IS NEEDED, USE BACK

If well telescopes please  
sketch and show depths.

GROUND LEVEL

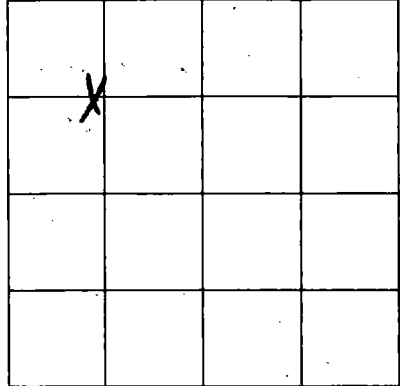

SECTION 13

Please indicate well location X.

ADDITIONAL INFORMATION

Lined area for additional information.

RECEIVED

1981 4 1 10 11

USE INSTRUCTIONS TO USE  
AND WELL LOGS

If more than one screen,  
show location of each on sketch.