

MISSISSIPPI DEPARTMENT OF ENVIRONMENTAL

QUALITY

Office of Land and Water Resources

P. O. Box 10631

Jackson, MS 39289-0631

WATER WELL DRILLERS LOG

COUNTY WELL LOCATED
Jackson
 WELL NUMBER CODED
N 725
 DATE WELL COMPLETED
11-14-98

PERMIT NUMBER
 NAME OF DRILLING FIRM
Coast Water Well Service

NAME & MAILING ADDRESS OF LANDOWNER
Glen Wiggall
Magnolia Lane
Ocean Springs, Ms
 WELL LOCATION SEC TOWNSHIP RANGE
34 7 N 8 W
 DISTANCE DIRECTION NEAREST TOWN
2 Miles *SE* of *OCEAN SPRINGS*
 OTHER LANDMARK
 WELL PURPOSE Home Irrigation, Municipal, Industrial, Fish Pond, etc.

PUMP DATA
 PUMP TYPE (Circle One):
 Submersible, Turbine, Jet, Flowing Well, Other (Describe) _____
 POWER TYPE (Circle One):
 Electric, Tractor, Diesel, Gasoline, Butane, Other (Describe) _____
 H/P *2*
 Pump Capacity (GPM) No. of Stages Setting Depth
10 *3* _____ FT.
 PUMP TEST
 Well yielded _____ GPM with a drawdown of _____ ft. after _____ hours of pumping

WELL DATA
 Well Depth Casing Diameter (In.) Casing Length (Ft.)
440' *2"* *430'*
 Type of Casing Hole Depth Depth to Static Water Level
Pvc *440'* *80'*

LOG DATA
 TYPE OF LOG RUN (Circle One):
 Electric, Gamma Ray, Density, Sonic, No Log Run, Neutron, Other (Describe) _____
 Name of Organization Running Log

TYPE OF COMPLETION: (Circle One or More):
 Gravel Packed, Underreamed, Telescoped, Natural Development, Open Hole, Other (Describe) _____

GEOLOGIC DATA (Office Use Only)

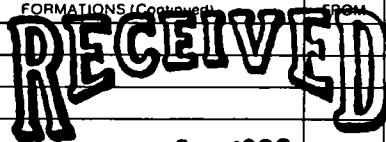
Surface Elev.	Geologic Unit	Unit Thickness	Depth to Top
Subs. SWL	Date	Analysis	Aquifer Test

WELL GROUTED TO A DEPTH OF *20* FEET
 Type Grout (circle one): Cement, Bentonite, or Mix

SCREEN DATA
 Diameter - Inches Length - Feet Slot Size - Inches
2" *10'* *.008*
 Screen Type Depth to Bottom - Feet
PVC *440'*

Driller's Remarks
 Top of Lap Pipe or Reduction in Casing
 FEET IF TELESOPED OR MORE THAN ONE SCREEN: USE BACK PAGE

DESCRIPTION OF FORMATIONS ENCOUNTERED	FROM	TO
<i>Top Soil</i>	<i>0</i>	<i>3</i>
<i>Med Coarse sand</i>	<i>3</i>	<i>20</i>
<i>Orange Blue silt clay</i>	<i>20</i>	<i>75</i>
<i>Fine Coarse sand</i>	<i>75</i>	<i>120</i>
<i>Blue Clay</i>	<i>120</i>	<i>140</i>
<i>Coarse sand</i>	<i>140</i>	<i>165</i>
<i>Blue clay</i>	<i>165</i>	<i>400</i>
<i>gray Coarse sand</i>	<i>400</i>	<i>440</i>

FORMATIONS (Continued) FROM TO

 JAN 25 1999
 Dept. of Environmental Quality
 Office of Land & Water Resources
 IF MORE SPACE IS NEEDED, USE BACK

If well telescopes please sketch and show depths.

GROUND LEVEL

		X	

SECTION 34

Please indicate well location X.

ADDITIONAL INFORMATION

RECEIVED

JAN 22 1980

Office of Land & Water Resources
Department of Environmental Control

If more than one screen,
show location of each on sketch.