

115. COLMERA CR  
06671N 3 PRINGS

MISSISSIPPI DEPARTMENT OF ENVIRONMENTAL QUALITY

Office of Land and Water Resources

P. O. Box 10631  
Jackson, MS 39289-0631  
WATER WELL DRILLERS LOG

COUNTY WELL LOCATED  
**Jackson**

WELL NUMBER: **N 732** CODED:

DATE WELL COMPLETED: **3-5-99**

PERMIT NUMBER: \_\_\_\_\_

NAME OF DRILLING FIRM: **Coast Water Well Service**

NAME & MAILING ADDRESS OF LANDOWNER: **Jack Leasure**  
**Ocean Springs Blvd. Rd.**  
**Ocean Springs, Ms**

WELL LOCATION: SEC **13** TOWNSHIP **7S** RANGE **8E**

DISTANCE **1** Miles DIRECTION **NE** of NEAREST TOWN **Ocean Springs**

OTHER LANDMARK: \_\_\_\_\_

WELL PURPOSE:  Home, Irrigation, Municipal, Industrial, Fish Pond, etc.

PUMP DATA

PUMP TYPE (Circle One): Submersible, Turbine,  Flowing Well, Other (Describe) \_\_\_\_\_

POWER TYPE (Circle One): Electric, Tractor, Diesel, Gasoline, Butane, Other (Describe) **H/P 2**

Pump Capacity (GPM) **9** No. of Stages **3** Setting Depth \_\_\_\_\_ FT.

PUMP TEST

Well yielded \_\_\_\_\_ GPM with a drawdown of \_\_\_\_\_ ft. after \_\_\_\_\_ hours of pumping

WELL DATA

Well Depth <b>390'</b>	Casing Diameter (In.) <b>2"</b>	Casing Length (Ft.) <b>380'</b>
Type of Casing <b>PVC</b>	Hole Depth <b>390'</b>	Depth to Static Water Level <b>100'</b>

TYPE OF COMPLETION: (Circle One or More):  Gravel Packed,  Underreamed,  Telescoped,  Natural Development,  Open Hole,  Other (Describe) \_\_\_\_\_

WELL GROUTED TO A DEPTH OF **20** FEET  
Type Grout (circle one): Cement, Bentonite, or Mix

LOG DATA

TYPE OF LOG RUN (Circle One):  No Log Run,  Electric,  Gamma Ray,  Density,  Sonic,  Neutron, Other (Describe) \_\_\_\_\_

Name of Organization Running Log \_\_\_\_\_

SCREEN DATA

Diameter - Inches <b>2"</b>	Length - Feet <b>10'</b>	Slot Size - Inches <b>.008</b>
Screen Type <b>PVC</b>	Depth to Bottom - Feet <b>390'</b>	

GEOLOGIC DATA (Office Use Only)

Surface Elev.	Geologic Unit	Unit Thickness	Depth to Top
Subs. SWL	Date	Analysis	Aquifer Test

Driller's Remarks

DESCRIPTION OF FORMATIONS ENCOUNTERED	FROM	TO
Top Soil	0	3
Orange gray blue clay	3	60
Coarse sand	60	75
Blue clay	75	90
Coarse sand	90	115
Blue clay	115	260
Rock 6" thick	200	
Wheat sand	260	275
Blue clay	275	350
Med-Coarse sand	350	390

FORMATION

**RECEIVED**


APR 12 1999

Dept. of Environmental Quality  
Office of Land & Water Resources

IF MORE SPACE IS NEEDED, USE BACK

If well telescopes please  
sketch and show depths.

GROUND LEVEL

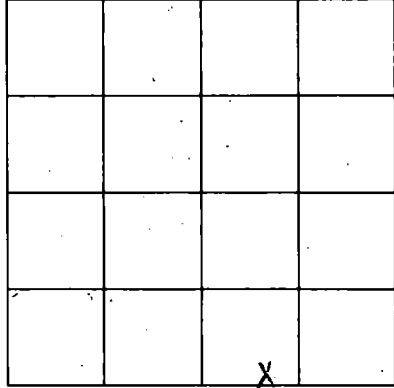

SECTION 13

Please indicate well location X.

ADDITIONAL INFORMATION

If more than one screen,  
show location of each on sketch.