

MISSISSIPPI DEPARTMENT OF ENVIRONMENTAL QUALITY
Office of Land and Water Resources

P. O. Box 10631
Jackson, MS 39289-0631
WATER WELL DRILLERS LOG

COUNTY WELL LOCATED Jackson	
WELL NUMBER W-	CODED
DATE WELL COMPLETED 4-27-00	

PERMIT NUMBER
NAME OF DRILLING FIRM Coast Water Well Service

NAME & MAILING ADDRESS OF LANDOWNER Danny Jalonovich Seacliff Dr. Ocean Springs MS			
WELL LOCATION	SEC 10	TOWNSHIP 8 S	RANGE 8 E
DISTANCE 3 Miles	DIRECTION SE	NEAREST TOWN Ocean Springs	
OTHER LANDMARK			
WELL PURPOSE (Home, Irrigation, Municipal, Industrial, Fish Pond, etc.) Home			

PUMP DATA		
PUMP TYPE (Circle One): Submersible, Turbine, Jet <input type="radio"/> Flowing Well, Other (Describe) _____		
POWER TYPE (Circle One): Electric , Tractor, Diesel, Gasoline, Butane, Other (Describe) _____ M/P 2		
Pump Capacity (GPM) 9	No of Stages 3	Setting Depth _____ FT.
PUMP TEST Well yielded _____ GPM with a drawdown of _____ ft. after _____ hours of pumping		

WELL DATA		
Well Depth 625'	Casing Diameter (in) 2"	Casing Length (Ft) 615'
Type of Casing PVC	Motor Depth 625'	Depth to Static Water Level 65'
TYPE OF COMPLETION (Circle One or More): Gravel Packed, Underreamed, Telescoped, Natural Development , Open Hole, Other (Describe) _____		
WELL GROUTED TO A DEPTH OF 20 FEET Type Grout (circle one): Cement, Bentonite, or Mix		

LOG DATA	
TYPE OF LOG RUN (Circle One): Electric, Gamma Ray, Density, Sonic, No Log Run , Neutron, Other (Describe) _____	
Name of Organization Running Log	

SCREEN DATA		
Diameter - inches 2"	Length - Feet 10'	Slot Size - inches .008
Screen Type PVC	Depth to Bottom - Feet 625'	


GEOLOGIC DATA (Office Use Only)			
Surface Elev	Geologic Unit	Unit Thickness	Depth to Top
Subs SWL	Date	Address	Aquifer Test
RECEIVED			
Driller's Remarks			
Top of Lap Pipe or Reduction in Casing			
FEET			
IF TELESCOPED OR MORE THAN ONE SCREEN, USE BACK PAGE			

DESCRIPTION OF FORMATIONS ENCOUNTERED	FROM	TO	FORMATION	FROM	TO
Top Soil	0	2	Red Clay	475	477
Blue Clay	2	10	Med Sand	477	498
Coarse Sand	10	30	Blue Clay	498	540
Blue Clay	30	30	Med Sand	540	625
Coarse Sand	50	70			
Blue Clay	70	130			
Med Sand	130	180			
Blue Clay to sand	180	360			
Med Sand	360	385			
Red Clay	385	400			
Med Sand	400	415			

IF MORE SPACE IS NEEDED, USE BACK

If well telescopes please sketch and show depths.

GROUND LEVEL

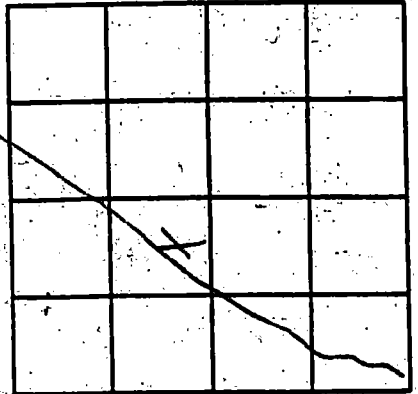

SECTION 10

Please indicate well location X.

ADDITIONAL INFORMATION

DECEMBER

JAN 1 1954

If more than one screen, show location of each on sketch.