

If well telescopes please sketch and show depths.


GROUND LEVEL

200' 4" PVC

220' 2" PV

10' 2" Screen

If more than one screen, show location of each on sketch.

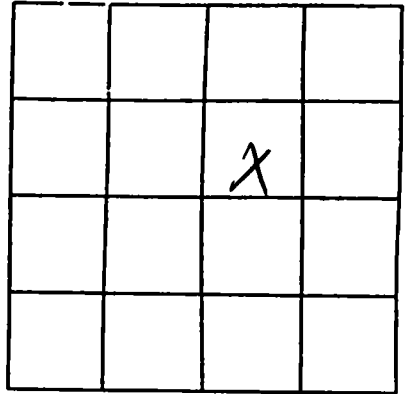

SECTION _____

Please indicate well location X.

Pump Capacity (GPM)	No. of Stages	Setting Depth
16	14	100 FT.

PUMP TEST

Well yielded 16 GPM with
 a drawdown of 3 ft.
 after 2 hours of pumping

LOG DATA

TYPE OF LOG RUN (Circle One): No Log Run, Electric, Gamma Ray, Density, Sonic, Neutron, Other (Describe) _____

Name of Organization Running Log _____

GEOLOGIC DATA (Office Use Only)

Surface Elev.	Geologic Unit	Unit Thickness	Depth to Top
Sube. SWL	Date	Analysis	Aquifer Test

Driller's Remarks

