

MISSISSIPPI DEPARTMENT OF ENVIRONMENTAL QUALITY
Office of Land and Water Resources

P. O. Box 10631
Jackson, MS 39289-0631
WATER WELL DRILLERS LOG

Jackson
COUNTY WELL LOCATED
Jackson
WELL NUMBER **N-70** CODED
DATE WELL COMPLETED
2-13-03

PERMIT NUMBER
NAME OF DRILLING FIRM
Crosby Drilling & Service Co.

NAME & MAILING ADDRESS OF LANDOWNER
Steve Landry
6728 Natchez St. Biloxi, MS
Latitude:
Longitude:
WELL LOCATION: SEC 8 TOWNSHIP 7 RANGE 9
DISTANCE _____ MILES _____ of _____ NEAREST TOWN *St. Martin*
OTHER LANDMARK _____
WELL PURPOSE Home Irrigation, Municipal, Industrial, Fish Pond, etc.

PUMP DATA
PUMP TYPE (Circle One):
Submersible, Turbine, Jet Flowing Well,
Other (Describe) _____
POWER TYPE (Circle One):
Electric, Tractor, Diesel, Gasoline, Butane,
Other (Describe) _____ H/P 1

DESCRIPTION OF FORMATIONS ENCOUNTERED	FROM	TO
<i>Top Soil</i>	<i>1</i>	<i>10</i>
<i>White Sand</i>	<i>10</i>	<i>20</i>
<i>Hard Blue Clay</i>	<i>20</i>	<i>35</i>
<i>Soft Blue Clay</i>	<i>35</i>	<i>220</i>
<i>Course Water Sand</i>	<i>220</i>	<i>230</i>
<i>Good Water Sand</i>	<i>230</i>	<i>270</i>

WELL DATA
Well Depth 250' Casing Diameter (In.) 2" Casing Length (Ft.) 240'
Type of Casing PVC Hole Depth 250' Depth to Static Water Level 60'
TYPE OF COMPLETION: (Circle One or More):
Natural Development, Gravel Packed, Underreamed, Telescoped,
Open Hole, Other (Describe) _____

WELL GROUTED TO A DEPTH OF 15 FEET
Type Grout (circle one): Cement, Bentonite, or Mix

SCREEN DATA
Diameter - Inches 2" Length - Feet 10' Slot Size - Inches .006
Screen Type PVC Depth to Bottom - Feet 250'

RECEIVED
MAR 17 2003
BY: OLWR

Top of Lap Pipe or Reduction in Casing _____
FEET IF TELESCOPED OR MORE THAN ONE SCREEN: USE BACK PAGE

I certify that the well was drilled, constructed and completed in accordance with all applicable Requirements of the Mississippi Department of Environmental Quality and/or the Mississippi Department of Health regulations and state laws.


Duff Meyer 0-209
Signature of Licensed Driller and License No.

3-14-03
Date

Additional Information Required On Back

If well telescopes please sketch and show depths.

GROUND LEVEL

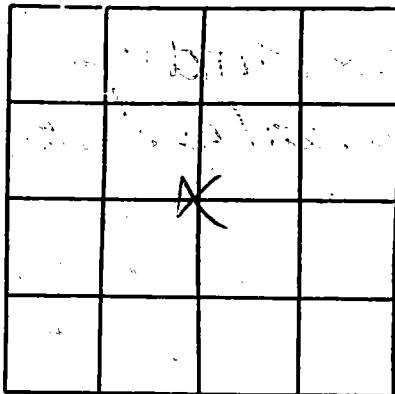

SECTION _____

Please indicate well location X.

Pump Capacity (GPM)	No. of Stages	Setting Depth
7	2	75 FT.

PUMP TEST

Well yielded 7 GPM with
 a drawdown of 0 ft.
 after 2 hours of pumping

LOG DATA

TYPE OF LOG RUN (Circle One): No Log Run, Electric, Gamma Ray, Density, Sonic, Neutron, Other (Describe) _____

Name of Organization Running Log _____

GEOLOGIC DATA (Office Use Only)

Surface Elev.	Geologic Unit	Unit Thickness	Depth to Top
Subs. SWL	Date	Analysis	Aquifer Test

Driller's Remarks

If more than one screen, show location of each on sketch.