

MISSISSIPPI DEPARTMENT OF ENVIRONMENTAL QUALITY

Office of Land and Water Resources

P. O. Box 10631
Jackson, MS 39289-0631
WATER WELL DRILLERS LOG

COUNTY WELL LOCATED
Jackson

WELL NUMBER CODED
NL 812

DATE WELL COMPLETED
5-12-03

PERMIT NUMBER

NAME OF DRILLING FIRM
East Water Well Service

NAME & MAILING ADDRESS OF LANDOWNER
Bull Ho
3308 N. 6th ST

Latitude:
Longitude: Ocean Springs

WELL LOCATION SEC 35 TOWNSHIP 7 N RANGE 8 W

DISTANCE 1 Miles DIRECTION SE of NEAREST TOWN Ocean Springs

OTHER LANDMARK

WELL PURPOSE Home, Irrigation, Municipal, Industrial, Fish Pond, etc.

PUMP DATA

PUMP TYPE (Circle One):
Submersible, Turbine, Jet, Flowing Well, Other (Describe) _____

POWER TYPE (Circle One):
 Electric, Tractor, Diesel, Gasoline, Butane, Other (Describe) _____ H/P 1

DESCRIPTION OF FORMATIONS ENCOUNTERED	FROM	TO
<u>Top Soil</u>	<u>0</u>	<u>1</u>
<u>Orange Clay</u>	<u>1</u>	<u>10</u>
<u>White Coarse Sand</u>	<u>10</u>	<u>18</u>
<u>Blue Clay</u>	<u>18</u>	<u>60</u>
<u>White Coarse Sand</u>	<u>60</u>	<u>72</u>
<u>Blue Clay</u>	<u>72</u>	<u>105</u>
<u>Gray Medium Sand</u>	<u>105</u>	<u>150</u>

WELL DATA

Well Depth 150' Casing Diameter (In.) 2" Casing Length (Ft.) 140'

Type of Casing PVC Hole Depth 150' Depth to Static Water Level 25'

TYPE OF COMPLETION: (Circle One or More):
 Gravel Backed, Underreamed, Telescoped, Natural Development, Open Hole, Other (Describe) _____

WELL GROUTED TO A DEPTH OF 60 FEET
Type Grout (circle one): Cement, Bentonite, or Mix

SCREEN DATA

Diameter - Inches 2" Length - Feet 10' Slot Size - Inches .006

Screen Type PVC Depth to Bottom - Feet 150'

RECEIVED

JUN 04 2003

BY: OLWR

Top of Lap Pipe or Reduction in Casing _____

FEET IF TELESCOPED OR MORE THAN ONE SCREEN: USE BACK PAGE


I certify that the well was drilled, constructed and completed in accordance with all applicable Requirements of the Mississippi Department of Environmental Quality and/or the Mississippi Department of Health regulations and state laws.

Jack Riddell, 472
Signature of Licensed Driller and License No.

5/31/03
Date

If well telescopes please sketch and show depths.

GROUND LEVEL

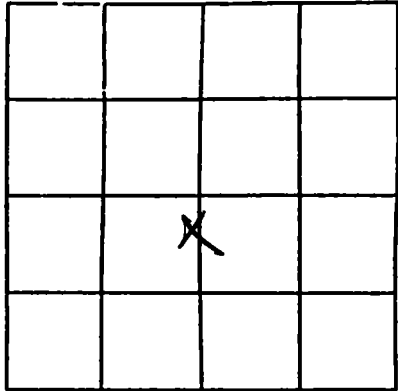

SECTION 35

Please indicate well location X.

Pump Capacity (GPM) <u>8</u>	No. of Stages <u>2</u>	Setting Depth FT.
---------------------------------	---------------------------	----------------------

PUMP TEST

Well yielded _____ GPM with a drawdown of _____ ft. after _____ hours of pumping

LOG DATA

TYPE OF LOG RUN (Circle One): No Log Run, Electric, Gamma Ray, Density, Sonic, Neutron, Other (Describe) _____

Name of Organization Running Log _____

GEOLOGIC DATA (Office Use Only)

Surface Elev.	Geologic Unit	Unit Thickness	Depth to Top
Subs. SWL	Date	Analysis	Aquifer Test

Driller's Remarks

If more than one screen, show location of each on sketch.