

MISSISSIPPI DEPARTMENT OF ENVIRONMENTAL QUALITY

Office of Land and Water Resources

P. O. Box 10631

Jackson, MS 39289-0631

WATER WELL DRILLERS LOG

COUNTY WELL LOCATED <i>Jackson</i>	
WELL NUMBER <i>N-861</i>	CODED
DATE WELL COMPLETED <i>March 17</i>	

PERMIT NUMBER <i>MM well</i>
NAME OF DRILLING FIRM <i>8827 Boss Hudy</i>
<i>Biloxi MO</i>

NAME & MAILING ADDRESS OF LANDOWNER <i>Reddy lawn NO</i>			
<i>Address</i>			
<i>corner of Johnson St & Daisy Vesty</i>			
Latitude:	<i>well not complete</i>		
Longitude:	<i>well not complete</i>		
WELL LOCATION	SEC <i>3</i>	TOWNSHIP <i>7S</i>	RANGE <i>9WE</i>
DISTANCE <i>on</i>	DIRECTION <i>Market of</i>	NEAREST TOWN <i>Hammer + Johnson</i>	
OTHER LANDMARK <i>By Johnson CO + Hammer CO</i>			
WELL PURPOSE: Home, Irrigation, Municipal, Industrial, Fish Pond, etc. <i>Home</i>			

PUMP DATA		
PUMP TYPE (Circle One): Submersible, Turbine, Jet, Flowing Well, Other (Describe) <i>None</i>		
POWER TYPE (Circle One): Electric, Tractor, Diesel, Gasoline, Butane, Other (Describe) <i>H/P</i>		
DESCRIPTION OF FORMATIONS ENCOUNTERED	FROM	TO
<i>orange clay</i>	<i>0-15</i>	
<i>white sand</i>	<i>15-45</i>	
<i>green clay</i>	<i>45-368</i>	
<i>sand</i>	<i>368-380</i>	
RECEIVED		
APR 21 2004		
BY: OLWR		
Top of Lap Pipe or Reduction in Casing		
FEET	IF TELESCOPED OR MORE THAN ONE SCREEN: USE BACK PAGE	

WELL DATA		
Well Depth <i>380</i>	Casing Diameter (In.) <i>PVC</i>	Casing Length (Ft.) <i>372</i>
Type of Casing <i>PVC</i>	Hole Depth <i>380</i>	Depth to Static Water Level <i>102</i>
TYPE OF COMPLETION: (Circle One or More): <input checked="" type="checkbox"/> Gravel Packed, <input type="checkbox"/> Underreamed, <input type="checkbox"/> Telescoped, <input checked="" type="checkbox"/> Natural Development, <input type="checkbox"/> Open Hole, <input type="checkbox"/> Other		
WELL GROUTED TO A DEPTH OF <i>11</i> FEET		
Type Grout (circle one): Cement, Bentonite, or Mix		

SCREEN DATA		
Diameter - inches <i>2</i>	Length - Feet <i>8</i>	Slot Size - inches <i>1006</i>
Screen Type <i>PVC</i>	Depth to Bottom - Feet <i>372-380</i>	

I certify that the well was drilled, constructed and completed in accordance with all applicable Requirements of the Mississippi Department of Environmental Quality and/or the Mississippi Department of Health regulations and state laws.


Al Medel 0563
Signature of Licensed Driller and License No.

April 19, 04
Date

Additional Information Required On Back

If well telescopes please sketch and show depths.

GROUND LEVEL

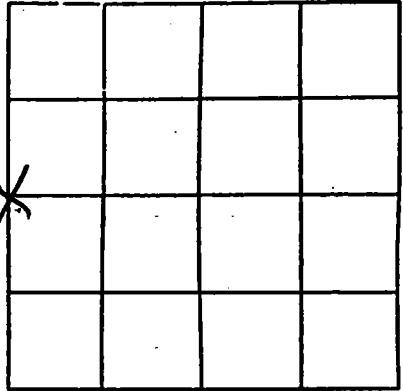

SECTION 3

Please indicate well location X.

Pump Capacity (GPM)	No. of Stages	Setting Depth
	<u>NONE</u>	_____ FT.

PUMP TEST

Well yielded _____ GPM with
 a drawdown of _____ ft.
 after _____ hours of pumping

LOG DATA

TYPE OF LOG RUN (Circle One): No Log Run.
 Electric, Gamma Ray, Density, Sonic, Neutron.
 Other (Describe) _____

Name of Organization Running Log

GEOLOGIC DATA (Office Use Only)

Surface Elev.	Geologic Unit	Unit Thickness	Depth to Top
Subs. SWL	Date	Analysis	Aquifer Test

Driller's Remarks

If more than one screen, show location of each on sketch.