:				
Talican	State Wel	-	For Office Use Only:	
county: <u>Jackson</u>	Mississippi Department o	Environmental Quality	Aquifer.	
Permit #:	Office of Land and		Well #: N-875059	
Driller: Coast Water Wellsrv.		P.O. Box 10631 Jackson, MS 39289-0631		
Date drilling completed: 9-1-04	(601)96	(601)961-5210		
	(601)354-6938 (fax)		E-log #:	
State Law requires that this re 30 days of completion of drilling	port be prepared by the dr g of the well.	•	والمتحدين والمسادة فسنت البرجيرين فيهيها بالمتحدين والمتحدين	
Well Owner Information			I Location	·
Owner Name Eldon Ladnier	I	atitude: <u>30 • 25 :345</u>	_" Longitude: 088 . 44 . 324"	
Mailing Address: 5517 Shadou	1 Street 1	lethod of Lat/Long (circle o	ne): Conventional Survey,	
		USGS quad, Hand-held	d GPS, Survey-grade GPS	
Ocean Spring	5 MS 39544	5 W 14 NE 14 Sec 21	Twn T75 RngR8W	
		Distance Direction	Nearest Town of <u>OCEAN Springs</u>	
Telephone No. (228) 872-670				
	Well Da			
Purpose of Well (circle one) Home		Irrigation Fish Culture	Other:	
Date well drilling started: 8-3		all drilling completed:(
If flowing, method of flow regulation:	Valve <u>N/A</u> Other (de	cribe)	0 1 01	
Static Water Level:fee	t above or below) (circle one) la	nd surface Date measured	: 7-1-04	
Method of Measurement (circle one)	steel tape electric tape		RECI	EIVED
Hole depth: 396' Well	depth: <u>396</u>	Well grouted to a depth of	FfeetSEP +	\$ 2004
Type of grout (circle one): Cement	Bentonite Mix			
Casing length: 38 feet C	Casing diameter:		PVC BY O	LWR
Screen length: 15 feet	Screen diameter:	_	PUC WRAPPOD	
Screen slot size: OCYinch	es Setting depth: From	<u>381</u> feet to	39.6feel	
Type of completion (circle all applicat	e): Gravel packed Under	eamed Telescoped Op	en hole Natural Development	
	Other (describc):	· · · · · · · · · · · · · · · · · · ·		
Top of lap pipe or reduction in casing	NA first. If te	escoped or more than one	screen, describe on back of page	
Logs run (circle all applicable): No lo	g run Electric Ganuna Ray	Density Sonic Neutron	Other:	-
Name of organization running log(s):	NA		In marks of the Missission	-
I certify that the well was drilled, co	instructed, and completed in a	ccordance with all applical	ne requirements or the mississippi	
Department of Environmental Qual	ity and/or the Mississippi Dep	artment of Health regulation	ons and state laws.	
Oack, Ridge	dell 0-472		k.Ridgdell	
Print Name of Water Well Contractor	and License No.	Signatur	e of Water Well Contractor	


N-875

If well telescopes please sketch below and show depths.

Ground Level

Description of Formations Encountered	From	To
TOPSOIL	-0	1d
Drange + Blue Clay White Coarse Sand	- à	28
white coarse sand	- 33	3/2
Blue Clay W/ STreaks OF SAND Gray Medium Sand	22	200
Gray Medium Sand	268	1274
		
		+
		+
		+
		\mathbf{T}
· · · · · · · · · · · · · · · · · · ·		
		1

If more than one screen, show location of each on sketch

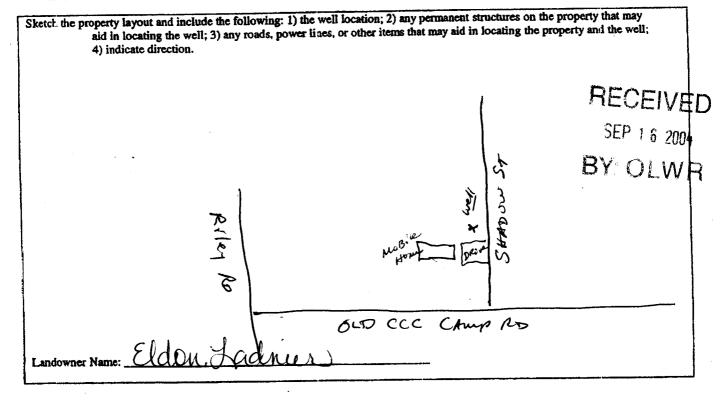

Signature of Well Contractor Water

County JACKSON Permit #: Driller: Coast Water Well Siev Date completed: <u>9-1-04</u>	STATE WELL REPORT Part 2 Pump Installer's Completion Report Mississippi Department of Environmental Quality Office of Land and Water Resources P.O. Box 10631 Jackson, MS 39289-0631 (601)961-5210 (601)354-6938 (fax)		Aquifer:	ice Use Only: -875	
This report should be prepared by th	e pump installer in deta	il and filed with the Departm	ent within 30 day	s of the	
installation of pump. Well Owner Informa	tion	1	ell Location		
Owner Name:_Eldon Ladnin	mer Name: Eldon Ladnier		Latitude: 30° 25. 315" Longitude: 088° 44.324"		
Lailing: Address: 5517 Shadow ST.		Method of Lat/Long (circle one): Conventional Survey,			
menting reactions.	<u> </u>				
Ocean Springs MS 39514 City State Zip Code		USGS quad, (Hand-held GPS.) Survey-grade GPS <u>SW 14</u> NF 14 Sec <u>24</u> Twn <u>T75</u> Rng <u>R8W</u> Distance Direction Nearest Town			
Telephone No. (228) 372 - 676	,8	Miles ENE	of Ocean	Springs	
			ower Type		
Pump Type Circle one		1	Circle one		
Air Lift (Jet)	Submersible	Diesel Engine Gaso	line Engine	Natural Gas	
Bucket Piston	Turbine	Electric Motor Han	đ	Tractor PTO	
Centrifugal Rotary	Flowing Well	Windmill Othe	er (specify):		
Other (specify): 2 HP		Horse Power Rating of Mot	or: <u>2 HP</u>) 	
Date Pump Installed: 9-2-0	24	Setting Depth: 120'1	proppipe		
Rated Pump Capacity: 8.5		Number of Stages:	3	SEP 16	
Pump Test Dat	A.	Method of I	Measuring Water		
Date Well Tested: <u>9-2-04</u>			Circle one		
Static Water Level (A): <u>95</u> Fe		Electric M	leasuring Line	Steel Tape	
		Other (specify):	ngan meningan pengan kanangan di sebuah kanangan di sebuah kanangan di sebuah kanangan di sebuah kanangan di s		
		1		110	
Pumping Water Level (B): <u>V/A</u> Fe		For flowing well, measured	shut in head:	MAL feet	
Pumping Water Level (B): $\frac{V/A}{Fe}$ Fe Drawciown {(B) - (A)]: $\frac{V/A}{Fe}$ Fe	et Below Land Surface	For flowing well, measured	-		
Pumping Water Level (B): <u>V/A</u> Fe	et Below Land Surface	For flowing well, measured Well yielded <u><i>B</i>.</u> 5 <u><i>N</i>/<i>A</i></u> feet after	GPM with a	a drawdown of	

Print Name of Pump Installer and License No. (if applicable)

•

•

Signature of Pump Installer