	State W	ell Report			
County: TACKSON Part 1		_	For Office Use Only:		
I N		t of Environmental Quality	Aquifer:		
Permit #:	Office of Land and Water Resources		Well #: <u>N= 1013</u>		
Driller Mast Water WellSN.	P.O. Box 10631				
Date drilling completed: 5-31-07		IS 39289-0631 961-5210	L. S. Elevation:		
Date drilling completed:() 1 ()_1		4-6938 (fax)	E-log #:		
	• •				
State Law requires that this report be prepared by the driller in detail and filed with the Department within 30 days of completion of drilling of the well.					
Well Owner Informati	on	Well	Location		
Owner Name_JOhn TOche		Latitude: <u>30 • 25 · 55</u>	" Longitude: <u>088 45 05(4</u> "		
Mailing Address: 5813 Toche	ng Address: 5813 Toche Dr.		Method of Lat/Long (circle one): Conventional Survey,		
	USGS quad, Hand-held		GPS) Survey-grade GPS		
Ocecun Sprikos, MS 39.564 City State Zip Code		ME 1/4 ME 1/4 Sec Z? Twn T75 Rng Rgilw			
Telephone No. (28) 875-570	Distance Direction		Nearest Town of <u>Denmisperiallys</u>		
Well Data					
Purpose of Well (circle one) Home Industrial Public Supply Irrigation Fish Culture Other:					
Date well drilling started: $5-31-07$ Date well drilling completed: $5-31-07$					
If flowing, method of flow regulation: Valve	= N A Other (d	escribe)			
Static Water Level: 30 feet above of below (circle one) land surface Date measured: 5-31-01					
Method of Measurement (circle one) steel tape electric tape air line other:					
Hole depth: 310' Well depth: 310' Well grouted to a depth of 10 feet					
Type of grout (circle one): Cement Bentonite Mix					
Casing length: <u>300</u> feet Casing diameter: <u>2</u> inches Type of casing: <u>DVC</u>					
Screen length: 10 feet Screen diameter: 2 inches Type of screen: 0VC					
Screen slot size: <u>•0004</u> inches Setting depth: From <u>300</u> feet to <u>310</u> feet					
Type of completion (circle all applicable): Gravel packed Underreamed Telescoped Open hole Natural Development					
	Other (describe):				
Top of lap pipe or reduction in casing:feet. If telescoped or more than one screen, describe on back of page					
Logs run (circle all applicable) No log run Electric Gamma Ray Density Sonic Neutron Other:					
Name of organization running log(s): NIA I certify that the well was drilled, constructed, and completed in accordance with all applicable requirements of the Mississippi					
Department of Environmental Quality and/or the Mississippi Department of Health regulations and state laws.					
Jack Ridadell 0-4	172		uffit for		
Print Name of Water Well Contractor and Li		1			
		L'al	JUN 2 8 2007		
			BY: OLWF		

).


•

N-1013

If well telescopes please sketch below and show depths.

	Description of Formations Encountered	From To
Ground Level	TOD SOIL	$ 0 \lambda$
	Orange Falue clau	<u> </u>
	Graumedium sand	119 134
	Blue Clay	134 290
	Gray medium sand	390310
	<u>J</u>	
•		

If more than one screen, show location of each on sketch

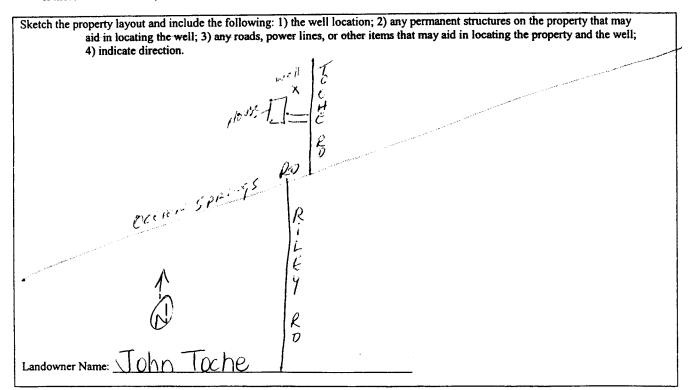

lel

Signature of Water Well Contractor

1/

JUN 2 8 2007

RECEIVED

BY: OLWR

STATE WELL REPORT						
County: JACKSON Permit #: Driller(<u>OQSH Water Well</u> SRV. Date completed: <u>5-31-07</u>	Pump Installer's Mississippi Departmen Office of Land a P.O. I Jackson, M (601)	art 2 s Completion Report t of Environmental Quality und Water Resources 30x 10631 1S 39289-0631 961-5210 4-6938 (fax)	For Office Use Only: Aquifer: Well #: M-1013 Elevation:			
This report should be prepared by the pump installer in detail and filed with the Department within 30 days of the						
installation of pump. Well Owner Information Owner Name: JOHN TOCHE Mailing Address: 58B TOCHE Dr. <u>Ocean Springs, MS 39569</u> City State Zip Code		Well Location Latitude: 30°35'554'' Longitude: 088°45'050'' 33 Method of Lat/Long (circle onc): Conventional Survey, USGS quad, Hand-held GPS, Survey-grade GPS NE 1/4 NE 1/4 Sec 2.3 Twn T 1/3 Rng R 360 Distance Direction Nearest Town 1/4 Miles				
Telephone No. (<u>228) 875 - 5702</u>	<u></u>	<u></u>	t _ Oleon Spar 45_			
Pump Type Circle one		Power Type Circle one				
	Submersible		ne Engine Natural Gas			
	Furbine (Electric Motor Hand	Tractor PTO			
CentrifugalRotaryOther (specify):		WindmillOtherHorse Power Rating of MotorSetting Depth: $(0.0 \ Ff \cdot C)$ Number of Stages:	NOP PIPE feet			
Pump Test Data		Method of Me	asuring Water Level			
Date Well Tested:	elow Land Surface elow Land Surface allons Per Minute	C Air Line Electric Mea Other (specify): For flowing well, measured sh Well yielded	ircle one suring Line Steel Tape nut in head: <u>NIA</u> feet			
I HEREBY CERTIFY that the above statements are true to the best of my knowledge. Image: Certify that the above statements are true to the best of my knowledge. JOCK-Ridgdell 0-472 Image: Certify that the above statements are true to the best of my knowledge. Print Name of Pump Installer and License No. (if applicable) Signature of Pump Installer JUN 28 2007						

۲

.

BY: OLWR