

County: Jackson

Permit #: MS-GW-16345

Driller: Griner Drilling Service Inc.

Date drilling completed: 3/5/2008

Well Driller Report and Well Log

Mississippi Department of Environmental Quality
 Office of Land and Water Resources
 P.O. Box 10631
 Jackson, MS 39289-0631
 (601) 961-5210
 (601) 354-6938 (fax)

For Office Use Only:

Aquifer: _____

Well #: N-1048

L.S. Elevation: _____

E-Log #: _____

State Law requires that this report be prepared by the driller in detail and filed with the Department within 30 days of completion of drilling of the well.

Well Owner Information	Well Location
Owner Name: <u>City of Ocean Springs</u>	Latitude: <u>30°25' 1.52" N</u> Longitude: <u>88°45' 50.55" W</u> <u>30 25 02 88 45 51</u>
Mailing Address: <u>1018 Porter Avenue</u>	Method of Lat/Long (circle one): <u>Conventional Survey</u> , <u>Google Earth</u> USGS quad, Hand-held GPS, Survey-grade GPS
<u>Oceans Springs, MS. 39564</u> City State Zip Code	<u>1/4 1/4 Sec 23 Twn 75 Rng 8w</u>
Telephone No. <u>(228) 875-3995</u>	Distance: <u>0.2 Miles</u> Direction: <u>W</u> of Nearest Town: <u>Deena Rd/Yosemite Dr. (Ocean Springs)</u>

Well Data

Purpose of Well (circle one) Home Industrial Public Supply Irrigation Fish Culture Other: _____

Date well drilling started: 11/27/2007 Date well drilling completed: 3/5/2008

If flowing, method of flow regulation: Valve _____ Other (describe) _____

Static Water Level: 106' feet above or below (circle one) land surface Date measured: 9/3/2008

Method of Measurement (circle one) steel tape electric tape air line other: _____

Hole depth: 640' Well depth: 510' Well grouted to a depth of 455' feet

Type of grout (circle one): Cement Bentonite Mix

Casing length: 455 feet Casing diameter: 12 3/4 inches Type of casing: steel

Screen length: 40 feet Screen diameter: 8 5/8 inches Type of screen: 304 SS

Screen slot size: -0.02 inches Setting depth: From 460 feet to 500 feet

Type of completion (circle all applicable): Gravel packed Underreamed Telescoped Open hole Natural development

Other (describe): _____

Top of lap pipe or reduction in casing: 388 feet. If telescoped or more than one screen, describe on back of page

Logs run (circle all applicable): No log run Electric Gamma Ray Density Sonic Neutron Other: _____

Name of organization running log(s): Griner Drilling Service Inc.

I certify that the well was drilled, constructed, and completed in accordance with all applicable requirements of the Mississippi Department of Environmental Quality and/or the Mississippi Department of Health regulations and state laws.

RECEIVED


JAN 16 2009

Griner Drilling Service 0-184
 Print Name of Water Well Contractor and License No.

Chub H. A. / BY: OLWR
 Signature of Water Well Contractor

If well telescopes please sketch below and show depths

N-1048

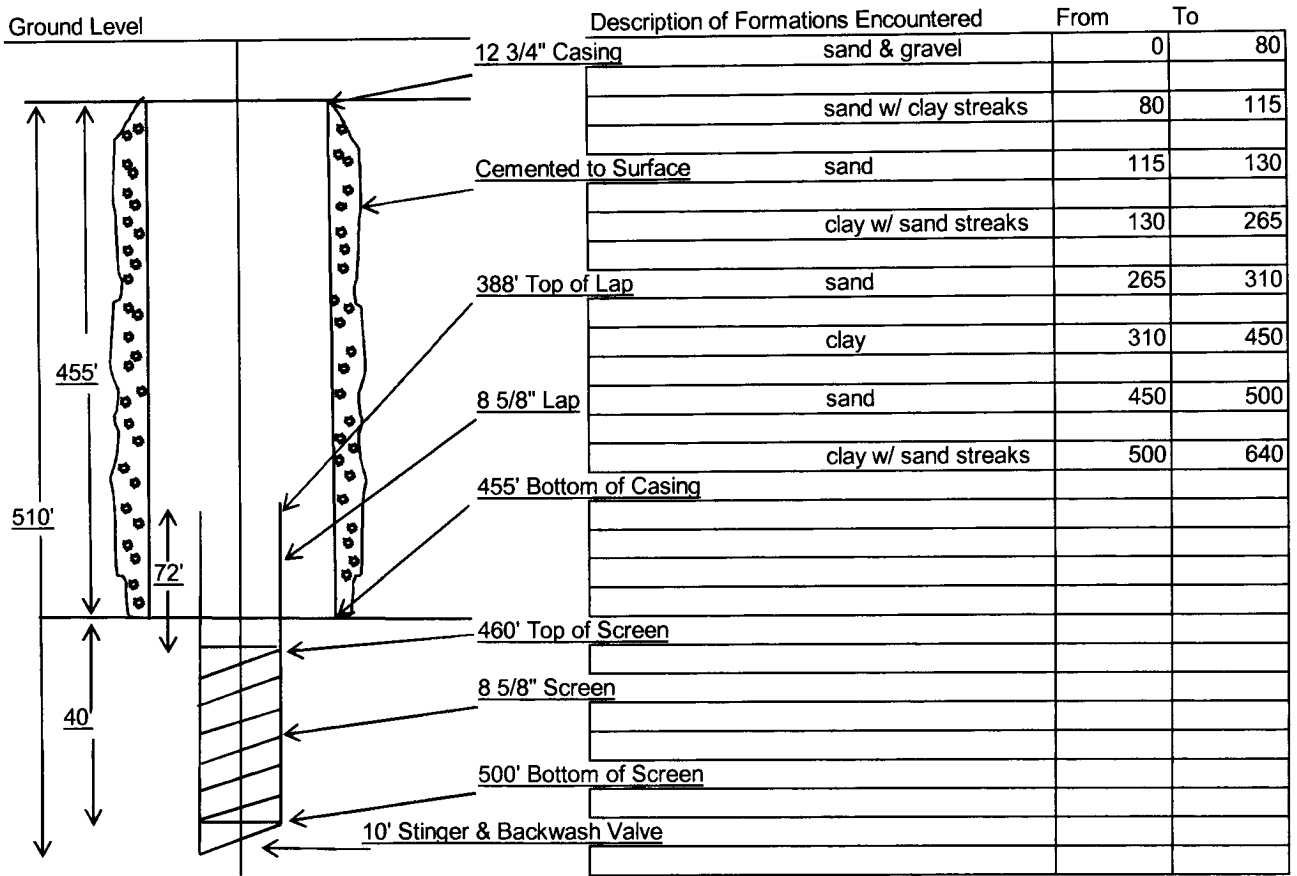

If more than one screen, show location of each on sketch

Sketch the property layout and include the following: 1) the well location; 2) any permanent structures on the property that may aid in locating the well; 3) any roads, power lines, or other items that may aid in locating the property and the well; 4) indicate direction.

SEE ATTACHED SATELITTE PHOTO

Landowner Name: _____

Chad H. [Signature]
 Signature of Water Well Contractor

RECEIVED
 JAN 16 2009
 BY: OLWR

STATE WELL REPORT

Part 2

Pump Installer's Completion Report

County: Jackson

Permit # : _____

Driller: Griner Drilling Service Inc.

Date Completed: 3/5/2008

Mississippi Department of Environmental Quality
Office of Land and Water Resources
P.O. Box 10631
Jackson, MS 39289-0631
(601)961-5210
(601)354-6938 (fax)

For Office Use Only:

Aquifer: _____

Well #: N-1098

Elevation: _____

This report must be prepared by the pump installer in detail and filed with the Department with 30 days of the installation of pump. A copy of Part 1 of this report must be attached to the report.

Well Owner Information	Well Location
Owner Name <u>City of Ocean Springs</u>	Latitude: <u>30°25' 1.52"N</u> Longitude: <u>88°45' 50.55" W</u>
Mailing Address: <u>1018 Porter Avenue</u>	Method of Lat/Long (circle one): Conventional Survey, Google Earth USGS quad, Hand-held GPS, Survey-grade GPS
<u>Ocean Springs</u> <u>MS.</u> <u>39564</u>	<u>1/4</u> <u>1/4</u> Sec <u> </u> Twn <u> </u> Rng <u> </u>
City State Zip Code	Distance Direction Nearest Town
Telephone No. <u>(228) 875-3995</u>	<u>0.2 Miles W</u> of <u>Deena Rd/Yosemite Dr. (Ocean Springs)</u>

Pump Type Circle one	Power Type Circle one
Air Lift <u>Jet</u> Submersible	Diesel Engine Gasoline Engine Natural Gas
Bucket Piton Turbine	Electric Motor Hand Tractor PTO
Centrifugal Rotary Flowing Well	Windmill Other (specify): _____
Other (specify): _____	Horse Power Rating of Motor: <u>75</u>
Date Pump Installed: <u>8/12/2008</u>	Setting Depth: <u>420</u> feet
Rated Pump Capacity: <u>350</u> Gallons per minute	Number of Stages: <u>6</u>

Pump Test Data	Method of Measuring Water Level Circle One
Date Well Tested: <u>9/3/2008</u>	Air Line Electric Measuring Line Steel Tape
Static Water Level (A): <u>160</u> Feet Below Land Surface	Other (specify): _____
Pumping Water Level (B): <u>350</u> Feet Below Land Surface	For flowing well, measured shut in head : <u> </u> feet
Drawdown {(B) - (A)} : <u>90</u> Feet Below Land Surface	Well yielded <u>390</u> GPM with a drawdown of
Test Pumping Rate: <u>390</u> Gallons Per Minute	<u>90</u> feet after <u>24</u> hours of pumping
Duration of Pump test (minimum 4 hours) : <u>2 4</u> hours	

I HEREBY CERTIFY that the above statements are true to the best of my knowledge.

Print Name of Pump Installer and License No. (if applicable)

Charles H. ...
Signature of Pump Installer

RECEIVED
JAN 16 2009
BY: OLWR