St:	ate Well Report	
County: Juckson	Part 1	For Office Use Only:
Mississippi De	partment of Environmental Quality	Aquifer:
Permit #: Office of	f Land and Water Resources P.O. Box 10631	Weil#: N1057
Driller COAST WATER WellSKU	kson, MS 39289-0631	L. S. Elevation:
Date drilling completed: <u>4309</u>	(601) 961-5210	
	(601) 354-6938 (fax)	E-log #:
State Law requires that this report be prepared 30 days of completion of drilling of the well.	by the driller in detail and filed v	with the Department within
Well Owner Information	Wei	l Location
Owner Name Ray Saujon	Latitude: <u>30 • 78</u>	2." Longitude 08 • 51 • 581 "
Mailing Address: 15009 Parker Rd	Method of Lat/Long (circle o	
	USGS quad, Kand-held	GPS Survey-grade GPS
City State Zip Code		Twn T 75 Rng Au
Telephone No. (238) 935-3237	<u>3/2</u> Miles NNW	Nearest Town of Oce And Sp. 21 mg S
Well For GARDE	Well Data	
Purpose of Well (circle on Home Industrial Public S		Other:
Date well drilling started:	Date well drilling completed:	7.3/07
If flowing, method of flow regulation: Valve <u>VA</u>	Other (describe)	
Static Water Level: 15 feet above or below circ	cle one) land surface Date measured:	6/3/09
Method of Measurement (circle one) steel tape elec	tric tape air line other:	
Hole depth: <u>85 FT.</u> Well depth: <u>85 f</u>	Well grouted to a depth of	l O feet
Type of grout (circle one): Cement Bentonite	Mix 7	Oile
Casing length:		
Screen length: feet Screen diameter:	inches Type of screen:	PUC
Screen slot size: inches Setting depth:	From 75 feet to	85 feet
Type of completion (circle all applicable): Gravel packed		hole Natural Development
Other (describe)):	
Top of lap pipe or reduction in casing: N/A fe	eet. If telescoped or more than one scr	een, describe on back of page
Logs run (circle all applicable) No log run Electric Gam	ama Ray Density Sonic Neutron	Other:
Name of organization running log(s): N/A I certify that the well was drilled, constructed, and compl	And in	
Department of Environmental Quality and/or the Mississ		
A OL A A A A A A A A A A A A A A A A A	ippi Department of nearth regulation	s and state laws.
Jack Ridgdell 0-472	Jack	Ridden
Print Name of Water Well Contractor and License No.	Signature of	Water Well Contempe CEIVE
	V	

· · ·

.

JUL 0 2 2009 BY: OLWR


Ta

If well telescopes please sketch below and show depths.



round Level	Description of Formations Encountered	From	To
	TOPSOIL	0	ス
	OCAME CLAN	la	15
	Gray clay w/otreaks of Sand Orange Coarse Sand	IS	75
	Grange, Coarse, Sand	75	85
	prarge		
		+	
		+	
	······································		╂[
			ļ
		<u> </u>	
		1	
		1	
		-	
		+	
		+	┝──┤
		1	L

If more than one screen, show location of each on sketch

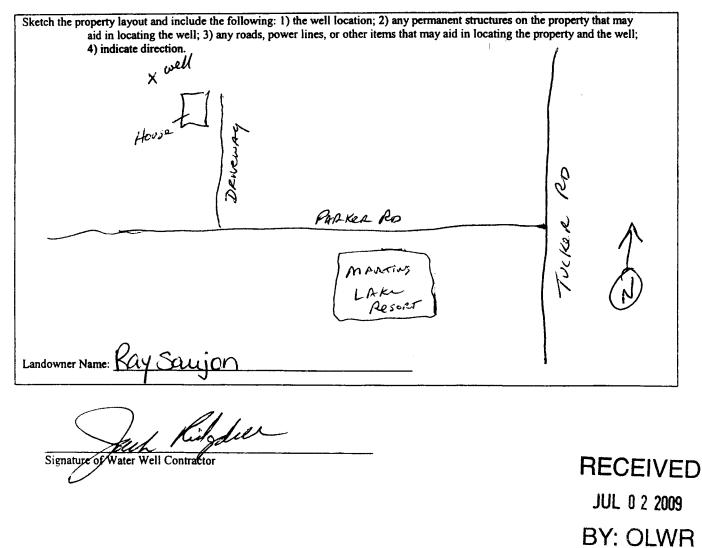

	STATE WI	ELL REPORT	
		art 2	For Office Use Only:
County: Jackson	Pump Installer's	Completion Report	
	Mississippi Departmen	t of Environmental Quality and Water Resources	Aquifer:
Permit #:		Box 10631	
Driller Coast Water Wel	LSKU Jackson, M	1S 39289-0631	Well #: N1057
Date completed: 6/3/09) 961-5210 54 6038 (fran)	Elevation:
	(601) 3	54-6938 (fax)	
This report should be prepared installation of pump.	ared by the pump installer in deta	il and filed with the Departm	nent within 30 days of the
Well Owner	Information	W	ell Location
Owner Name: Ray Sau	ijon	Latitude: 30 28'08	" Longitude 08 51 581 "
Mailing Address: 1500		O S Method of Lat/Long (circle	one): Conventional Survey, 3.5
		USGS quad, Ha	nd-held GPS, Survey-grade GPS
Oceans	ring Ms 79564	She 1/ NE 1/4 Sec	2 Twn T75 RngR 9W
City	prings Ms 39564 State Zip Code	SE NW Distance Direction	Nearest Town
Telephone No. 208 935	3237	31/2 Miles NNW	of OCEAN Springs
		· · · · · · · · · · · · · · · · · · ·	
-	e one		Power Type Circle one
Air Lift Jet	Submersible	Diesel Engine Gaso	line Engine Natural Gas
Bucket Piston	Turbine	Electric Motor Hand	d Tractor PTO
Centrifugal Rotary	Flowing Well		er (specify):
Other (specify):		Horse Power Rating of Moto	or: 1 HP
Date Pump Installed: 6/3	109	Setting Depth: 40FT.	Droppipeteet
Rated Pump Capacity:		Number of Stages:	2
Pumo 7	'est Data	Method of N	feasuring Water Level
Date Well Tested:			Circle one
Static Water Level (A):	Feet Below Land Surface	Air Line Electric M	easuring Line Steel Tape
Pumping Water Level (B): <u>N</u>		Other (specify):	
Drawdown [(B) - (A)]:		For flowing well, measured	shut in head: N/A feet
Test Pumping Rate:			GPM with a drawdown of
Duration of Pump Test (minimum	1 4 hours):hours	N/A feet after	NA hours of pumping
L	· · · · · · · · · · · · · · · · · · ·	1	······································
I HEREBY CERTIFY that the ab	ove statements are true to the best of	f my knowledge.	
The la Diladoll	0-1177		Relin pro-
UNCK RIGYCH	U Y 102	Signature of Pump	RECEIVED
Print Name of Pump Installer and	License No. (II applicable)	Signature of Pump	JUL 0 2 2009
		-	
			BY: OLWR

•

.