	State W	ell Report	For Office Lies Only	
County: Jackson		art 1	For Office Use Only:	
	Mississippi Departmen	t of Environmental Quality	Aquifer: <u>N 1064</u>	
Permit #:		and Water Resources 30x 10631	Well #:	
Driller COast Water UEllsev	Jackson, MS 39289-0631		L. S. Elevation:	
Date drilling completed: 2-1-10	,	961-5210	E les #i	
]	(601) 35	54-6938 (fax)	E-log #:	
State Law requires that this repo 30 days of completion of drilling	ort be prepared by the of the well.			
Well Owner Informa			l Location	
Owner Name Floyd Brune		Latitude: <u>30° 26', 447</u> Longitude: <u>18° 49', 731</u> "		
Mailing Address: 13135 Ru-	h ST.	Method of Lat/Long (circle of		
			GPS Survey-grade GPS	
Ocean pring:	<u>5, MS 3956</u> 4 zip Code		Twn 778 Rng R8 W	
Telephone No. 288, 348 - 12, C	.4	Distance Direction Miles	Nearest Town of Ocenw Sparry 5	
	Well	Data		
Purpose of Well (circle one) Home Indu	strial Public Supply	Irrigation Fish Culture	Other:	
Date well drilling started:		-	-110	
If flowing, method of flow regulation: Val	1			
Static Water Level:feet abo	ove or velow circle one) l	and surface Date measured:_	2-1-10	
Method of Measurement (circle one) ste	el tape electric tape	air line other:		
Hole depth: <u>AIFT</u> . Well dept	h: <u>alift.</u>	Well grouted to a depth of	10 feet	
	Bentonite Mix			
Casing length: <u>d</u> feet Casing	g diameter:	inches Type of casing:	PVC	
Screen length:feet Scree	n diameter: 2	inches Type of screen:	P.VC	
Screen slot size: • OO; inches	Setting depth: From	201 feet to	<u>}</u> feet	
Type of completion (circle all applicable):	-		hole Natural Development	
Top of lap pipe or reduction in casing:	/	escoped or more than one scre		
Logs run (circle all applicable) No log run	Electric Gamma Ray	Density Sonic Neutron	Other:	
Name of organization running log(s): //	//t			
Department of Environmental Quality and				
	- or the initialization Dep	AT THERE OF THEATED LERGISLIODS	anu state laws.	
Jack Kidgdell 0-4	72		Raylen	
Print Name of Water Well Contractor and L	icense No.	Signature of		
			FEB 1 1 2010	

BY: OLWR

N1004


If well telescopes please sketch below and show depths.

Ground Level

٠,

Description of Formations Encountered	From	То
 TODSOIL	D	2
 Gravelay	2	30
White Cod rse Sand W streaks of Chy	30	700
Blueclay	100	200
Gray Coarse Sand	300	110
Bray com se Sup	<u></u>	
	<u> </u>	
	<u>├</u>	
	┨─────	<b>  </b>
	I	┟
	<u> </u>	<b> </b>
·	<u> </u>	$\square$
	L	ļ
	-	
	1	
	t	1
	<u>†                                     </u>	
	ــــــ	L

If more than one screen, show location of each on sketch

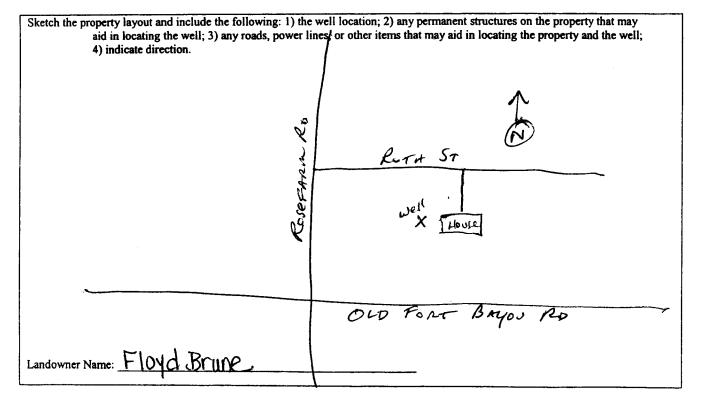

file an

Signature of Water Well Contractor

RECEIVED FEB 1 1 2010 BY: OLWR

		STATE WE	ELL REPORT	N1064
County: Jack	'son	Part 2 Pump Installer's Completion Report Mississippi Department of Environmental Quality Office of Land and Water Resources		For Office Use Only: Aquifer:
Permit #: Driller: COAST	WaterWellsk			Well #: Elevation:
Date completed:	2-1-10			
This report st	hould be prepared by th	e pump installer in deta	il and filed with the Departm	ent within 30 days of the
installation of	Well Owner Informat	ion	1	ll Location
Owner Name: Floyd Brune, Mailing Address: 13125 Ruth ST.			Latitudes 30° 36′ 443 <sup>™</sup> Longitude: 088° 49′ 731 Method of Lat/Long (circle one): Conventional Survey,	
Ç	Cean Spring	<u>35, MS 39</u> 564- Zip Code		Twin 75 Rng R & W
			Distance Direction	Nearest Town
Telephone No.	\$348-120	)4	Miles	of Ocour Janip
	Ритр Туре			wer Type
	Circle one		C	Circle one
Air Lift	Jet	Submersible	Diesel Engine Gasoli	ne Engine Natural Gas
Bucket	Piston	Turbine (	Electric Motor Hand	Tractor PTO
Centrifugal	Rotary	Flowing Well		(specify):
Other (specify):			Horse Power Rating of Motor	
Date Pump Installe	- <u>2-2-10</u>		Setting Depth: <u>40FT.</u>	Droppipetet
Rated Pump Capac	ity: <u>9,5</u>	Gallons Per Minute	Number of Stages:	2
Pump Test Data		Method of Measuring Water Level		
Date Well Tested:	<u>a-a-10</u>			ircle one
Static Water Level (A):Feet Below Land Surface			isuring Line Steel Tape	
Pumping Water Lev	vel (B): NA Feet I	Below Land Surface	Other (specify):	
Drawdown [(B) – (A)]: $N/A$ Feet Below Land Surface		For flowing well, measured sl	nut in head: <u>NA</u> feet	
Test Pumping Rate: 9.5 Gallons Per Minute		Well yielded GPM with a drawdown of		
Duration of Pump	Test (minimum 4 hours):	4/2-hours	N/A feet after	N/A hours of pumping
			~ · · · · · · · ·	
TACK K	r i that the above statem Ridgdell 0-4	ents are true to the best of 72	t my knowledge.	Chdere RECEN
Print Name of Pum	p Installer and License N	o. (if applicable)	Signature of Pump In	Istaller
			1	FEB 112
				BA: OF

•