State W	ell Report	For Qffiçe Use Only:		
	art 1	Aquifer: 1078		
Mississippi Department				
	Office of Land and Water Resources P.O. Box 10631			
	IS 39289-0631	L. S. Elevation:		
	(601) 961-5210 (601) 354-6938 (fax) E-log #:			
State Law requires that this report be prepared by the driller in detail and filed with the Department within				
30 days of completion of drilling of the well. Well Owner Information		l Location		
Owner Name Torge, Alverdin	Latitude: 30 · 22 49.Q	2" Longitude: 088. 45.13.12		
Mailing Address: 2700 N. 12th Street	Method of Lat/Long (circle or	ne): Conventional Survey,		
		I GPS.) Survey-grade GPS		
		Twn <u>785</u> Rng <u>R8</u> W		
Telephone No. 008 348-3009	Distance Direction	of Ocenn Springs		
Weil Data				
Purpose of Well (circle one) Home Industrial Public Supply Irrigation Fish Culture Other: Date well drilling started: 10/17/11 Date well drilling completed: 10/19/11				
If flowing, method of flow regulation: Valve <u>N/A</u> Other (describe)				
Static Water Level:				
Method of Measurement (circle one) steel tape electric tape air line other:				
Hole depth: <u>455 FT</u> . Well depth: <u>455 FT</u> . Well grouted to a depth of <u>10</u> feet				
Type of grout (circle one): Cement Bentonite Mix				
Casing length: <u>445</u> feet Casing diameter: <u>a</u> inches Type of casing: <u>pVC</u>				
Screen length: <u>10</u> feet Screen diameter: <u>2</u> inches Type of screen: <u>PVC</u> .				
Screen slot size: , 00 (einches Setting depth: From445feet to455feet				
Type of completion (circle all applicable): Gravel packed Underreamed Telescoped Open hole Natural Development				
Other (describe):				
Top of lap pipe or reduction in casing: 1/A feet. If telescoped or more than one screen, describe on back of page				
Logs run (circle all applicable) No log run Electric Gamma Ray Density Sonic Neutron Other:				
Name of organization running log(s): N/4				
I certify that the well was drilled, constructed, and completed in accordance with all applicable requirements of the Mississippi Department of Environmental Quality and/or the Mississippi Department of Health regulations and state laws.				
Took Ridodall Outoo				
Print Name of Water Well Contractor and License No.	Ach-	Water Well Contractor		
		Lewis Printing - Pascagoula, MS		

•

4.


SP. UMR

If well telescopes please sketch below and show depths.

Ground Level

Description of Formations Encountered	From	10
 TOSCI	$\Box O$	a
Nance Clay	A	12
	112	22
White coarsa said	15	ШĨ
Blue. Clay	Sin	IFE
Gray Meckinn Sand	440	422
	+	
	+	
	·	
		L

If more than one screen, show location of each on sketch

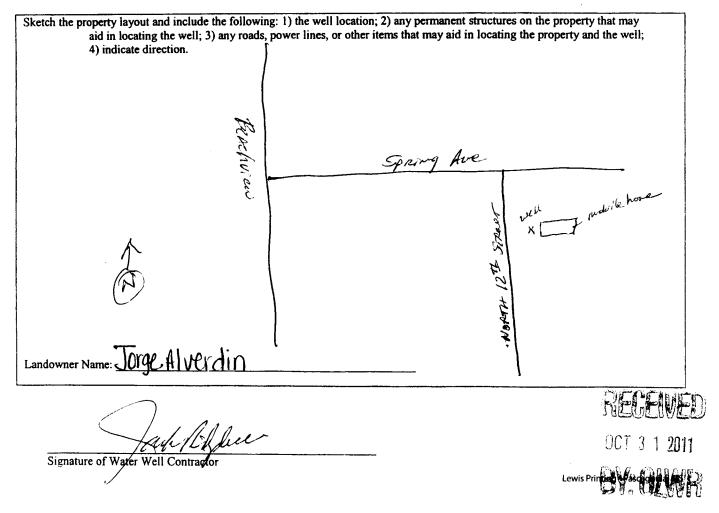

STATE WELL REPORT			
County DUCKSON Permit #: Driller UDIST 1/D + Cr WPIISR V. Date completed: 10-19-11 Date completed: 10-19-11 Date completed: 10-19-11 County DUCKSON Pump Installer Mississippi Departmen Office of Land a P.O. I Jackson, M (601) (601) 3	art 2 For Office Use Only: s Completion Report Aquifer: N 1078 and Water Resources N 1078 Box 10631 Well #: 1961-5210 Elevation:		
This report should be prepared by the pump installer in deta	il and filed with the Department within 30 days of the		
installation of pump. Well Owner Information Owner Name: Irgl: Alverdin Mailing Address: DIOON. Dth St. <u>Ocean Springs</u> , ME 39564 City State Zip Code Telephone No. DR8 348 - 3507	Well Location Latitude: <u>D</u> ⁰ <u>D</u> ¹ <u>49.00</u> Longitude: <u>088</u> ^c <u>45</u> <u>13.62</u> ^U <u>49</u> Method of Lat/Long (circle one): Conventional Survey, USGS quad. <u>Hand-held GPS</u> Survey-grade GPS <u>W</u> <u>4 NE</u> <u>4 Sec</u> <u>D</u> <u>Twn</u> <u>185</u> Rn <u>K</u> <u>8</u> Distance Direction Nearest Town <u>114</u> <u>Miles</u> <u>SE</u> of <u>OCCANSPINGS</u>		
Pump Type Circle one	Power Type Circle one		
Air Lift Jet Submersible	Diesel Engine Gasoline Engine Natural Gas		
Bucket Piston Turbine	Electric Motor Hand Tractor PTO		
Centrifugal Rotary Flowing Well Other (specify):	Windmill Other (specify): Horse Power Rating of Motor: 211P Setting Depth: DFT. Dr Opfipefeet Number of Stages: 3		
Pump Test Data	Method of Measuring Water Level Circle one		
Date Well Tested:	Air Line Electric Measuring Line Steel Tape Other (specify):		
Drawdown [(B) – (A)]:Feet Below Land Surface	For flowing well, measured shut in head: NA feet		
Test Pumping Rate: Gallons Per Minute Duration of Pump Test (minimum 4 hours): 4 //2_hours	Well yielded GPM with a drawdown of		
I HEREBY CERTIFY that the above statements are true to the best of JACK. KIAQALL D-472 Print Name of Pump installer and License No. (if applicable)	f my knowlødge. Right Right Signature of Pump Installer Lewis Printing - Pasçagoula, MS		

÷

· ·