

JACKSON MISSISSIPPI BOARD OF WATER COMMISSIONERS

N 2000

Cont locate

WATER WELL DRILLERS LOG

6-9-62

Date: 6-9, 1962, Driller: George Colville County Jackson

(Name)

(1) Owner of Land: <u>Edgar Talbert</u> <small>(Name)</small>	Description & Color of Materials Sand, Clay, Red Clay, Shell, etc.	Thick- ness Feet	Depth Feet
<u>Ocean Springs, Miss.</u> <small>(Address)</small>	<u>Clay</u> <u>Blue Clay/sand strks</u> <u>Sand</u>	<u>21</u> <u>399</u> <u>30</u>	<u>21</u> <u>420</u> <u>450</u>
(2) Location: <u>NW 1/4, NW 1/4, Sec. 24 T25R9W</u>			
<u>15</u> miles <u>NE</u> of <u>Ocean Springs</u> <small>(distance) (direction) (Nearest Town)</small>			
(3) Topography: <u>FLAT</u> <small>(Hilly) (Flat) (Level)</small>			
(4) Purpose of Well: <u>Domestic</u> <small>(Domestic Irrigation Municipal, Industrial, Other)</small>			


Information upon completion of well:

- (1) Diameter 1 1/2 inches.
- (2) Total Depth 450 feet.
- (3) Water Level 19 feet below top of ground.
- (4) Cased to 730, Size _____
- (5) Screen: Size 80 mesh, Length 10
- (6) Were any formations sealed against pollution?
_____ yes, no.

If YES depth of formation _____

Why _____

Drillers Remarks: _____

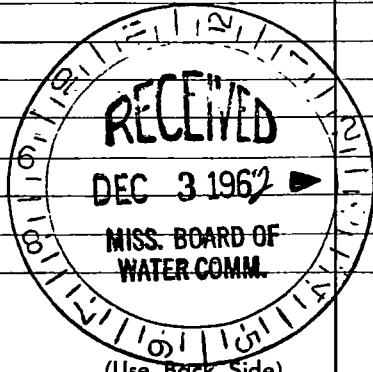

Well No. 139

