

JACKSON MISSISSIPPI BOARD OF WATER COMMISSIONERS

N 2001 cont. locate

2-26-63

WATER WELL DRILLERS LOG

Date: Feb. 26, 1963, Driller: L. S. Garland County Jackson

(Name)

(1) Owner of Land: Mr. Benefield
 (Name)
 O. S. Miss
 (Address)

Description & Color of Materials
 Sand, Clay, Red Clay, Shell, etc. Thickness
 Feet Depth
 Feet

(2) Location: 1/4, 1/4, Sec. 23 759 W
 (distance) miles (direction) of (Nearest Town)

1 10' Clay 11' S.
 2 19' Sand 2' M.
 3 Mud
 4 Max
 5 "
 6 "
 7 "
 8 Mud
 9 "
 10 "
 11 1' Sand Str.
 12 Sand

(3) Topography: (Hilly) (Flat) (Level)

(4) Purpose of Well: Dom.
 (Domestic Irrigation
 Municipal, Industrial, Other)

Information upon completion of well:

(1) Diameter 2 inches.

(2) Total Depth 252 feet.

(3) Water Level 49 feet below top of ground.

(4) Cased to _____, Size _____

(5) Screen: Size .08, Length 10'

(6) Were any formations sealed against pollution?
 _____ yes, _____ no.


If YES depth of formation _____

Why _____

Drillers Remarks: _____

252
 -10

 242
 Cost 2

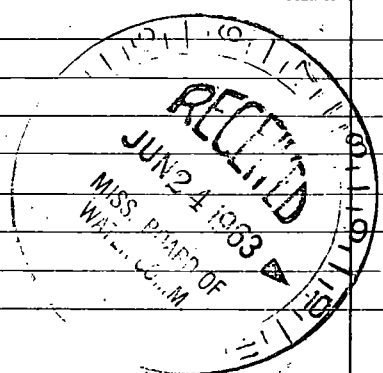

(Use Back Side)

Well No.

