

JACKSON MISSISSIPPI BOARD OF WATER COMMISSIONERS

N 2003 *Locate*

WATER WELL DRILLERS LOG

4-8-63

Date: Apr. 8, 1963, Driller: L. L. Garland County Jackson

(Name)

(1) Owner of Land: Mr. Macy
(Name)

O. S.
(Address)

(2) Location: 1/4, 1/4, Sec. 40 T75 R8 W

 miles of
(distance) (direction) (Nearest Town)

(3) Topography: Flat
(Hilly) (Flat) (Level)

(4) Purpose of Well: Dom.
(Domestic Irrigation
Municipal, Industrial, Other)

Information upon completion of well:

(1) Diameter 2 inches.

(2) Total Depth 435 feet.

(3) Water Level Flowed feet below top of ground.

(4) Cased to , Size

(5) Screen: Size .08, Length 10'


(6) Were any formations sealed against pollution?
 yes, no.

If YES depth of formation

Why

Drillers Remarks:

	Description & Color of Materials Sand, Clay, Red Clay, Shell, etc.	Thick- ness Feet	Depth Feet
1	Mud & Sand Strk		
2	Sand		
3	Mix.		
4	"		
5	Sand		
6	Mud		
7	"		
8	"		
9	"		
10	Mix.		
11	"		
12	"		
13	Shale		
14	Mud		
15	"		
16	"		
17	"		
18	Mix.		
19	"		
20	"		
21	Sand		
22	14' Sand		

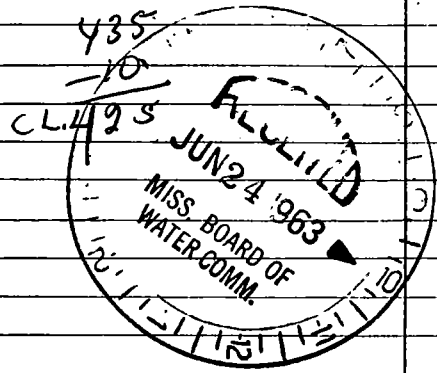

(Use Back Side)

Well No.

