

JACKSON
 N 2005
 7-26-75

MISSISSIPPI
 BOARD OF WATER COMMISSIONERS
 416 North State Street
 135 Jackson, Mississippi 39201

WATER WELL DRILLERS LOG

COASTAL DRILLING & SERVICE CO. *Jackson*
 ROUTE #1m BOX 618 County well located

7/26 1975
 date well completed

LANDOWNER *C.T. Richard* BILOXI, MISS 39532

Rt 3 Box 122A
Biloxi, Miss 39532
 (mailing address)


WELL LOCATION:
 sec. *10-T-7* R. *9*
3 1/2 miles *W* of *Half Hills*
 (distance) (direction) (nearest town)

WELL PURPOSE: *Home*
 (home, irrigation, municipal, industrial)

WELL COMPLETION DATA:
 (1) diameter (inches) *4 1/2"*
 (2) total depth (feet) *267'*
 (3) static water level (feet) *40* ^{below}/_{above} top of ground.
 (4) casing *PVC 2 1/2"*
 (material) (depth)
 (size) if telescope see back.
 (5) screen *15'* *2 1/2"*
 (length) (depth to top)
2" *PVC*
 (size) (material)
 (6) pump *One* *20*
 (HP) (yield gpm)
Ele
 (type power)
 (7) electric log *no*
 (yes or no)
 (organization running log)


Description of formations encountered	from	to
<i>Top Soil</i>	<i>1</i>	<i>3</i>
<i>Red rock</i>	<i>3</i>	<i>5</i>
<i>Red Clay</i>	<i>5</i>	<i>15</i>
<i>White Sand</i>	<i>15</i>	<i>47</i>
<i>Soft Blue Clay</i>	<i>47</i>	<i>160</i>
<i>fine Sand</i>	<i>160</i>	<i>170</i>
<i>Hard Blue Clay</i>	<i>170</i>	<i>220</i>
<i>fine water Sand</i>	<i>220</i>	<i>245</i>
<i>Coarse water Sand</i>	<i>245</i>	<i>267</i>

(8) how well bottom plugged
2" hard work blue
 DRILLERS REMARKS:
me

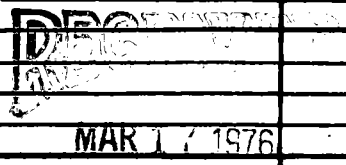

If well telescopes please sketch and show depths.

GROUND LEVEL

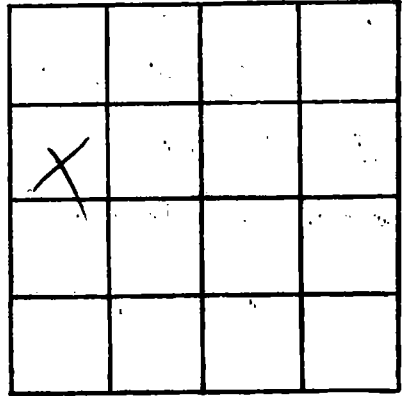

SECTION _____

Please indicate well location X.

ADDITIONAL INFORMATION

A series of horizontal lines for writing additional information.

If more than one screen, show locations of each on sketch.