

JACKSON
 N 2009
 9-20-75

MISSISSIPPI
 BOARD OF WATER COMMISSIONERS
 416 North State Street
 138 Jackson, Mississippi 39201


WATER WELL DRILLERS LOG

20 SEPT 1975 BAYBENT WELL CO JACKSON
 date well completed firm name county well located

LANDOWNER: <u>WAYNE TRONEY</u> <u>RT 3 Box 292</u>	description of formations encountered	from	to
<u>OCEAN SPRINGS, Ms.</u> (mailing address)	<u>SAND</u>	<u>0</u>	<u>60</u>
WELL LOCATION: sec. <u>23</u> T. <u>7</u> R. <u>3</u> <u>2</u> miles <u>NE</u> of <u>OCEAN SPRINGS</u> (distance) (direction) (nearest town)	<u>CLAY</u>	<u>60</u>	<u>79</u>
WELL PURPOSE: <u>HOME</u> (home, irrigation, municipal, industrial)	<u>CLAY w/sand streaks</u>	<u>79</u>	<u>108</u>
WELL COMPLETION DATA: (1) diameter (inches) <u>2</u>	<u>CLAY</u>	<u>108</u>	<u>263</u>
(2) total depth (feet) <u>491</u>	<u>FINE SAND</u>	<u>263</u>	<u>294</u>
(3) static water level (feet) <u>47</u> <u>below</u> top of ground.	<u>CLAY</u>	<u>294</u>	<u>336</u>
(4) casing <u>PVC</u> , <u>476</u> (material) (depth)	<u>SAND</u>	<u>336</u>	<u>394</u>
If telescope see back. (size)	<u>CLAY</u>	<u>394</u>	<u>444</u>
(5) screen <u>5'</u> , <u>476</u> (length) (depth to top)	<u>GOOD SAND</u>	<u>444</u>	<u>491</u>
<u>209</u> , <u>PVC</u> (size) (material)			
(6) pump <u>1</u> <u>10</u> (HP) (yield gpm)			
<u>ELECT</u> (type power)			
(7) electric log <u>NO</u> (yes or no)			
(organization running log)			
(8) how well bottom plugged <u>METAL</u> <u>SAND SAND</u>			
DRILLERS REMARKS:			

If well telescopes please sketch and show depths.

GROUND LEVEL

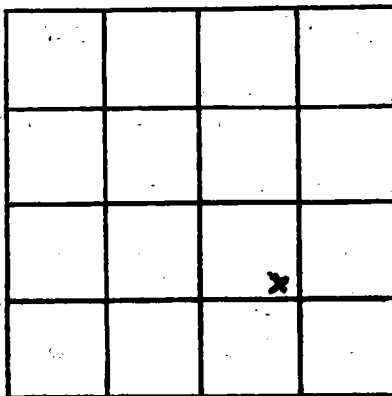

SECTION 23

Please indicate well location X.

ADDITIONAL INFORMATION

If more than one screen, show locations of each on sketch.