

JACKSON
N 2011
11-12-75

MISSISSIPPI
BOARD OF WATER COMMISSIONERS
416 North State Street
Jackson, Mississippi 39201

WATER WELL DRILLERS LOG
COASTAL DRILLING & SERVICE CO.

11/12 1975
date well completed

ROUTE 1 BOX 618
firm name

Jackson
county well located

LANDOWNER: DW Loney, BILOXI, MISS. 39532

description of formations encountered

from to

RT 3 Box 139

Top Soil

1 2

Biloxi, Miss
(mailing address)

Red Clay
white Sand
slam

3 30
30 60
60 65

WELL LOCATION:

sec. 10 T 2 S R 9
(3) 1/4 miles NW of Hill
(distance) (direction) (nearest town)

Red Sand
Silt Clay
fine white Sand

65 90
90 210
210 230

WELL PURPOSE: home
(home, irrigation, municipal, industrial)

hard blue Clay
fine white Sand
Coarse white Sand

230 435
435 450
450 555

WELL COMPLETION DATA:

- (1) diameter (inches) 2"
- (2) total depth (feet) 555'
- (3) static water level (feet) 22' (below top of ground)
- (4) casing PVC, 545' (material) (depth)

If telescope see back.
(size)

- (5) screen 10' 545' (length) (depth to top)
- 2" PVC (size) (material)

- (6) pump one 15 (HP) (yield gpm)


Oil (type power)

- (7) electric log no (yes or no)

(organization running log)

- (8) how well bottom plugged 2" hard wash blue


DRILLERS REMARKS:
none

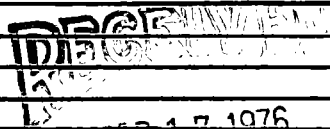

MAR 17 1976

If well telescopes please sketch and show depths.

GROUND LEVEL

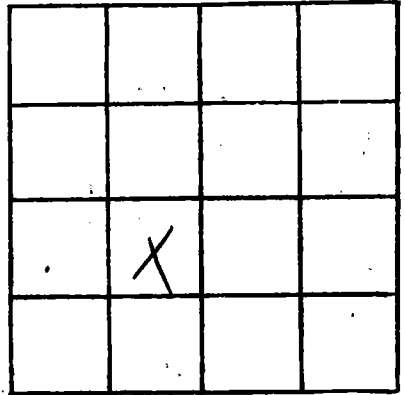

SECTION _____

Please indicate well location X.

ADDITIONAL INFORMATION

If more than one screen, show locations of each on sketch.