

JACKSON
 N 8012
 2/17/76

MISSISSIPPI
 BOARD OF WATER COMMISSIONERS
 416 North State Street
 Jackson, Mississippi 39201

WATER WELL DRILLERS LOG

2/17 1976 COAST WATER WELL SERVICE INC. Jackson
 date well completed firm name county well located

LANDOWNER: Bill Meyers
1204 Bristol Blvd
Ocean Springs, Ms.
 (mailing address)

WELL LOCATION:
 sec. 8 T. 8 R. 8
2 miles SE of Ocean Springs
 (distance) (direction) (nearest town)

WELL PURPOSE: home
 (home, irrigation, municipal, industrial)

- WELL COMPLETION DATA:
- diameter (inches) 2"
 - total depth (feet) 464'
 - static water level (feet) 26' ^{below} ~~above~~ top of ground.
 - casing pvc 2 1/2"
 (material) (depth)
2"
 (size) If telescope see back.
 - screen 10' 2 1/2"
 (length) (depth to top)
 - pump 1/2 7
 (HP) (yield gpm)
Elec.
 (type power)
 - electric log No
 (yes or no)
 - (organization running log)
 - how well bottom plugged blw valve

description of formations encountered	from	to
Top Soil	0	10
Red Fine Sand	10	15
Blue Clay & Clam Shell	15	24 1/2
Blue Clay & streak of Blue Fine sand	24 1/2	26 7
Blue Clay	26 7	32 6
Blue Clay & streaks of Gray Med. Fine sand	32 6	43 2
Gray Coarse Sand & Gravel	43 2	46 9
		None


RECEIVED
 JUN 28 1976

MISS. BD. OF WATER COMM.

DRILLERS REMARKS:

If well telescopes please sketch and show depths.

GROUND LEVEL

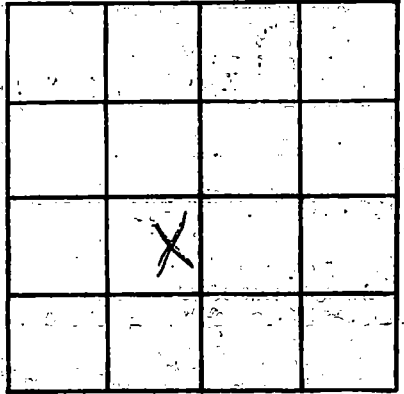

SECTION 35

Please indicate well location X.

ADDITIONAL INFORMATION

Lined area for additional information.

Handwritten scribbles

If more than one screen, show locations of each on sketch.