

JACKSON  
 N 2013  
 4-5-76

MISSISSIPPI  
 BOARD OF WATER COMMISSIONERS  
 416 North State Street  
 Jackson, Mississippi 39201

WATER WELL DRILLERS LOG  
 COASTAL DRILLING & SERVICE CO.

*Jackson*

135  
 date well completed 4/17/76  
 ROUTE 1 BOX 618  
 firm name PILOXI MISS 30532

county well located

LANDOWNER: Clayton Home

| description of formations encountered | from | to  |
|---------------------------------------|------|-----|
| Top Soil                              | 1    | 2   |
| Red Clay                              | 2    | 15  |
| Red Sand                              | 15   | 22  |
| White Sand                            | 22   | 110 |
| Flame                                 | 110  | 115 |
| Sandy Sand                            | 115  | 140 |
| Soft Blue Clay                        | 140  | 220 |
| Hard Blue Clay                        | 220  | 240 |
| Hard Blue Clay                        | 240  | 415 |
| Hard Water Sand                       | 415  | 450 |
| Coarse Water Sand                     | 450  | 485 |

Ocean Springs, Miss  
 (mailing address)

WELL LOCATION:  
 sec 13 T 7 N R 8 E  
3.1 miles NE of Ocean Springs  
 (distance) (direction) (nearest town)

WELL PURPOSE: home  
 (home, irrigation, municipal, industrial)

- WELL COMPLETION DATA:
- (1) diameter (inches) 4 1/2"
  - (2) total depth (feet) 485'
  - (3) static water level (feet) 40' below above top of ground
  - (4) casing PVC, 470'  
(material) (depth)  
4 1/2" If telescope see back.  
(size)
  - (5) screen 15', 470'  
(length) (depth to top)  
2", PVC  
(size) (material)
  - (6) pump One Shot 20  
(HP) (yield gpm)  
3 hp  
(type power)
  - (7) electric log no  
(yes or no)
- (organization running log)


(8) how well bottom plugged  
29 inch hole / 1/2 inch

DRILLERS REMARKS:  
none

APR 17 1976

If well telescopes please sketch and show depths.

GROUND LEVEL

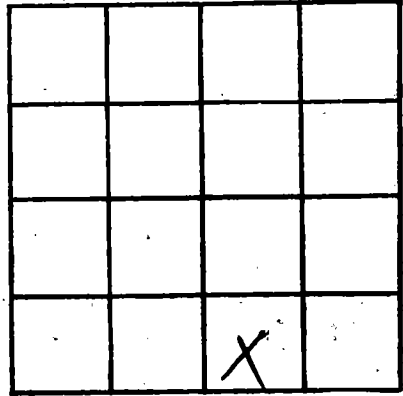

SECTION \_\_\_\_\_

Please indicate well location X.

ADDITIONAL INFORMATION

A series of horizontal lines for writing additional information.

If more than one screen, show locations of each on sketch.