

**JACKSON**  
 N 2014  
 5/11/76

MISSISSIPPI  
 BOARD OF WATER COMMISSIONERS  
 416 North State Street  
 Jackson, Mississippi 39201

WATER WELL DRILLERS LOG  
 COASTAL DRILLING & SERVICE CO.

8/11/76  
 Date well completed

ROUTE 1 BOX 618  
 Rm. name

*Jackson*  
 county well located

Along with Builders  
 LANDOWNER:

Loche Best Builders  
 Ocean Springs, Miss  
 (mailing address)

description of formations encountered	from	to
top soil	1	3
white sand	3	60
5 shells	60	70
Soft blue clay	70	130
shells	130	140
white sand	140	170
Soft blue clay	170	200
light blue clay	200	340
fine white sand	340	360
Coarse white sand	360	400

WELL LOCATION:

sec. 13 T. 2 N. R. 8 E  
 (3) Three miles NE Ocean Springs  
 (distance) (direction) (nearest town)

WELL PURPOSE: Best yard  
 (home, irrigation, municipal, industrial)

WELL COMPLETION DATA:

- (1) diameter (inches) 2"
- (2) total depth (feet) 700'
- (3) static water level (feet) 18 (below above top of ground)
- (4) casing PVC, 390'  
(material) (depth)
- (size) if telescope see back.
- (5) screen 10', 390'  
(length) (depth to top)
- 2", PVC  
(size) (material)
- (6) pump One 1.5  
(HP) (yield gpm)
- Ele  
(type power)
- (7) electric log no  
(yes or no)

(organization running log)

(8) how well bottom plugged  
2" diameter hole

DRILLERS REMARKS:

none




MAY 20 1976

MISS. Bd. OF WATER COMMISSIONERS

If well telescopes please sketch and show depths.

GROUND LEVEL

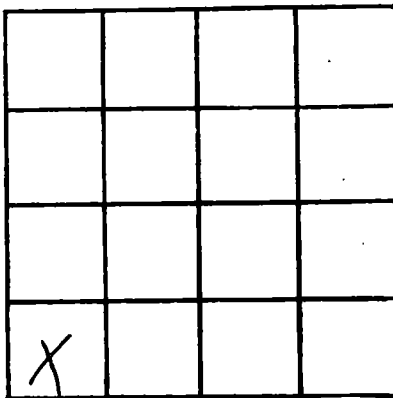

SECTION \_\_\_\_\_

Please indicate well location X.

ADDITIONAL INFORMATION

If more than one screen,  
show locations of each on sketch.