

**JACKSON**  
 N 2015  
 5/13/76

MISSISSIPPI  
 BOARD OF WATER COMMISSIONERS  
 416 North State Street  
 Jackson, Mississippi 39201

WATER WELL DRILLERS LOG  
 COASTAL DRILLING & SERVICE CO.

*Jackson*  
 county well located

5/13/76 date well completed  
 ROUTE 1 BOX 618  
 BILOXI, MISS. 39532

LANDOWNER: *HA. Cannon*

Rt 6 Box 632  
 Biloxi, Miss  
 (mailing address)

WELL LOCATION:  
 sec. 3 T. 7 S. R. 9 E.  
 (3) three miles S latitude  
 (distance) (direction) (nearest town)

WELL PURPOSE: home  
 (home, irrigation, municipal, industrial)

WELL COMPLETION DATA:

- (1) diameter (inches) 2"
- (2) total depth (feet) 425'
- (3) static water level (feet) 30 <sup>below</sup>/<sub>above</sub> top of ground.
- (4) casing PVC 4.5'  
 (material) (depth)  
 (size) If telescope see back.
- (5) screen 10' 4.5'  
 (length) (depth to top)  
2" PVC  
 (size) (material)
- (6) pump one 15'  
 (HP) (yield gpm)  
Elc  
 (type power)
- (7) electric log no  
 (yes or no)

(organization running log)


(8) how well bottom plugged  
2' backwash valve  
 DRILLERS REMARKS

description of formations encountered	from	to
top soil	1	3
Red Clay	3	15
white sand	15	39
Soft Blue Clay	39	80
Silt. Sand	80	100
White Sand	100	160
Soft Blue Clay	160	300
Hard Blue Clay	300	320
fine water sand	320	340
hard blue clay	340	385
Coarse water silt	385	425

MAY 17 1976

If well telescopes, please sketch and show depths.

GROUND LEVEL

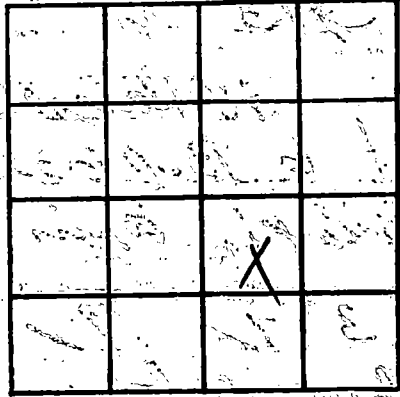

SECTION \_\_\_\_\_

Please indicate well location X.

ADDITIONAL INFORMATION

If more than one screen, show locations of each on sketch.