

**JACKSON**  
 N 2016  
 5/13/76

MISSISSIPPI  
 BOARD OF WATER COMMISSIONERS  
 416 North State Street  
 Jackson, Mississippi 39201

WATER WELL DRILLERS LOG  
 COASTAL DRILLING & SERVICE CO.

*Jackson*  
 county well located

5/13/76  
 date well completed

ROUTE 1 BOX 118  
 well name

BILOXI, MISS. 39532

LANDOWNER: *Stan Ramsey*  
*Old Hwy 90*  
*Ocean Springs Drive*  
 (mailing address)

description of formations encountered	from	to
Top Soil	1	3
Sand & Clay	3	15
white sand	15	40
Sft Blue Clay	40	240
fine water sand	240	260
Sft Blue Clay	260	310
fine water sand	310	325
hard blue clay	325	405
Shells	405	410
hard blue clay	410	460
fine water sand	460	475
Coarse water sand	475	525

WELL LOCATION:  
 sec. 14 T. 2 N R. 9 E  
 1/2 mile miles W Gulf Hills  
 (distance) (direction) (nearest town)

WELL PURPOSE: *none*  
 (home, irrigation, municipal, industrial)


WELL COMPLETION DATA:  
 (1) diameter (inches) 24  
 (2) total depth (feet) 525'  
 (3) static water level (feet) 20 <sup>below</sup>/<sub>above</sub> top of ground.  
 (4) casing PVC, 515'  
 (material) (depth)  
 (size) if telescope see back.  
 (5) screen 10', 515'  
 (length) (depth to top)  
24, PVC  
 (size) (material)  
 (6) pump one 13  
 (HP) (yield gpm)  
5hp  
 (type power)  
 (7) electric log no  
 (yes or no)  
 (organization running log)

(8) how well bottom plugged  
*21' back with valve*

DRILLERS REMARKS:  
*none*

If well telescopes please sketch and show depths.

GROUND LEVEL

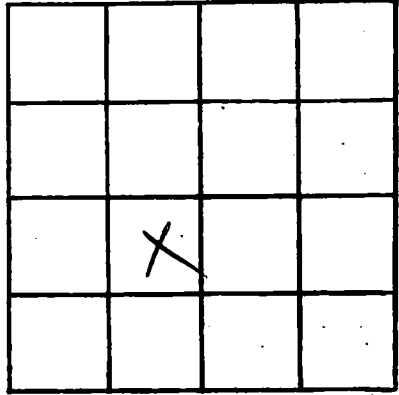

SECTION \_\_\_\_\_

Please indicate well location X.

ADDITIONAL INFORMATION

If more than one screen, show locations of each on sketch.