

JACKSON
 N 2019
 8-13-76

MISSISSIPPI
 BOARD OF WATER COMMISSIONERS
 416 North State Street
 Jackson, Mississippi 39201

WATER WELL DRILLERS LOG
 COASTAL DRILLING & SERVICE CO.

8/13/76 19 ROUTE 1 BOX 618
 date well completed
 BILOXI, MISS 30532
 firm name

Jackson
 county well located

LANDOWNER: San Lourey Realty
Ocean Springs, Miss
 (mailing address)

description of formations encountered	from	to
Top Soil	1	3
Red Clay	3	10
Soft Blue Clay	10	25
Coarse white Sand	25	78
Soft Blue Clay	78	140
Sliver Sand	140	170
Soft Blue Clay	170	190
Hard Blue Clay	190	300
fine water sand	300	340
Hard Blue Clay	340	390
fine water sand	390	430
Clay Crack	430	460
fine water sand	460	470
Coarse water sand	470	500

WELL LOCATION:
 sec 14 T 7 N R 9 E
1 1/2 miles West of West Hill
 (distance) (direction) (nearest town)

WELL PURPOSE: home
 (home, irrigation, municipal, industrial)

WELL COMPLETION DATA:
 (1) diameter (inches) 2"
 (2) total depth (feet) 500'
 (3) static water level (feet) 23' below top of ground.
 (4) casing PVC, 490'
 (material) (depth)
 (size) If telescope see back.
 (5) screen 10', 490'
 (length) (depth to top)
2", PVC
 (size) (material)
 (6) pump One, 14
 (HP) (yield gpm)
3/4
 (type power)
 (7) electric log no
 (yes or no)
 (organization running log)

(8) how well bottom plugged 2'
hard packed gravel


DRILLERS REMARKS:

RECEIVED
 JAN 31 1977

MISS. BD. OF WATER COMM

If well telescopes please sketch and show depths.

GROUND LEVEL

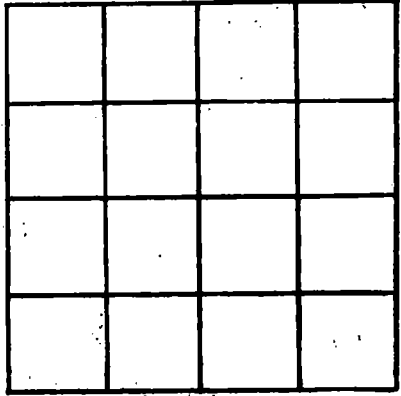

SECTION _____

Please indicate well location X.

ADDITIONAL INFORMATION

If more than one screen, show locations of each on sketch.