

JACKSON  
 N 2024  
 9-4-76  
 9/4/76

MISSISSIPPI  
 BOARD OF WATER COMMISSIONERS  
 416 North State Street  
 Jackson, Mississippi 39201

WATER WELL DRILLERS LOG

COASTAL DRILLING & SERVICE CO.

Jackson

date well completed

ROUTE 1 BOX 618

county well located

LANDOWNER:

BILOXI, MISS. 39532

Description of formations encountered

from to

Dr. Hermy 15012  
 Le. Mound Blvd  
 Biloxi (mailing address)

Top Soil	1	3
Red Clay	3	12
Soft Blue Clay	12	18
Coarse white Sand	18	90
Soft Blue Clay	90	130
Shaggy Sand	130	150
Soft Blue Clay	150	180
Hard Blue Clay	180	280
fine water sand	280	315
hard Blue Clay	315	440
fine water sand	440	460
clay Coarse water sand	460	485

WELL LOCATION:

sec 14 T 7 S R 9 E  
 (2.5) miles West Gulf Hills  
 (distance) (direction) (nearest town)

WELL PURPOSE:

(home, irrigation, municipal, industrial) home

WELL COMPLETION DATA:

- (1) diameter (inches) 4 1/2"
- (2) total depth (feet) 485'
- (3) static water level (feet) 25' <sup>below</sup> <sub>ground</sub> top of ground.
- (4) casing PVC, 470' (material) (depth)  
 4 1/2" (size) If telescope see back.
- (5) screen 15' 470' (length) (depth to top)  
 2" (size) PVC (material)
- (6) pump one 3/4 hp 20 (HP) (yield gpm)  
 Ele (type power)
- (7) electric log no (yes or no)

(organization running log)

(8) how well bottom plugged

rock with valve

DRILLERS REMARKS:

good well

RECEIVED  
 JAN 31 1977

MISS. BD. OF WATER COMM

If well telescopes please sketch and show depths.


GROUND LEVEL

4" PVC Casing  
160'

310' 2"  
PVC Casing

15ft 2" PVC  
Screen  
2" bed wash pipe

If more than one screen,  
show locations of each on sketch.

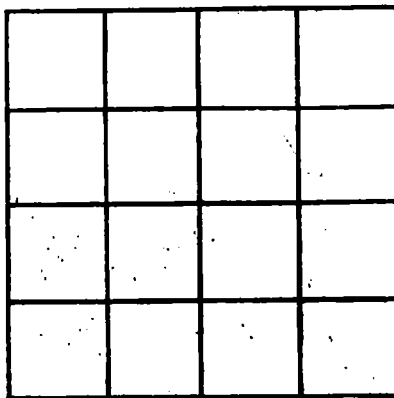

SECTION \_\_\_\_\_

Please indicate well location X.

ADDITIONAL INFORMATION

Lined area for additional information.