

JACKSON
 N 2022
 9-5-76

MISSISSIPPI
 BOARD OF WATER COMMISSIONERS
 416 North State Street
 Jackson, Mississippi 39201

WATER WELL DRILLERS LOG
 COASTAL DRILLING & SERVICE CO.

9/5/76
 date well completed

ROUTE 1 BOX 618
 location

Jackson
 county well located

LANDOWNER: Wood

BLOOM, MISS. 39532

description of formations encountered

from to

Comfort Homes
 Ocean Spring, Miss
 (mailing address)

Top Soil	1	2
White Sand	2	100
Soft Blue Clay	100	120
fine water sand	120	135
fine water sand	135	160
Wood Chip	160	180
Soft Blue Clay	180	210
Hard Blue Clay	210	220
fine water sand	220	235
Coarse water sand	235	240

WELL LOCATION:

sec. 13 T. 7 N. R. 8 E
 5 miles East Hill Hill
 (distance) (direction) (nearest town)

WELL PURPOSE:

(home, irrigation, municipal, industrial)
Water

WELL COMPLETION DATA:

- (1) diameter (inches) 4 1/2"
- (2) total depth (feet) 1680'
- (3) static water level (feet) 20' below top of ground
- (4) casing PVC, 665'
 (material) (depth)
4 1/2"
 (size) If telescope see back.
- (5) screen 15', 665'
 (length) (depth to top)
2", PVC
 (size) (material)
- (6) pump One 30
 (HP) (yield gpm)
Ele
 (type power)
- (7) electric log no
 (yes or no)

(organization running log)

(8) how well bottom plugged 2"
head with valve

DRILLERS REMARKS:

RECEIVED

FEB - 4 1977

If well telescopes please sketch and show depths.


GROUND LEVEL

200ft 4"
PVC Casing

465' 2" PVC
Casing

15ft 2" PVC screen
5" backwash valve

If more than one screen,
show locations of each on sketch.

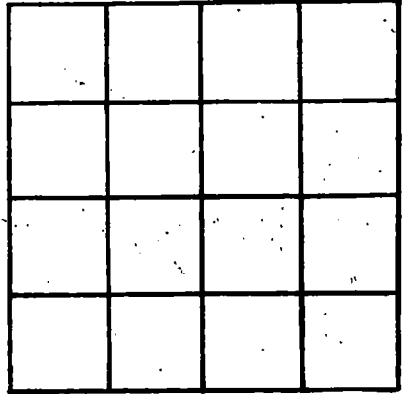

SECTION _____

Please indicate well location X.

ADDITIONAL INFORMATION

Multiple horizontal lines for additional information.