

JACKSON  
 N 2023  
 9-25-76

MISSISSIPPI  
 BOARD OF WATER COMMISSIONERS  
 416 North State Street  
 Jackson, Mississippi 39201

WATER WELL DRILLERS LOG

GARLAND WATER WELLS

25 SEP 1976 date well completed      firm name      JACKSON county well located

LANDOWNER: ARNOLD VERHOVEN  
 2500 PARKWOOD PLACE  
 OCEAN SPRINGS, MS 39564  
 (mailing address)

description of formations encountered	from	to
TOP SOIL	0	2
SAND	2	18
MUD	18	27
SAND	27	50

WELL LOCATION:  
 sec. 28 T 7 S R 5 W  
 0 miles N/R of OCEAN SPRINGS  
 (distance) (direction) (nearest town)

WELL PURPOSE: IRRIGATION  
 (home, irrigation, municipal, industrial)

- WELL COMPLETION DATA:
- (1) diameter (inches) 2"
  - (2) total depth (feet) 44' well
  - (3) static water level (feet) 11' <sup>below</sup> above top of ground.
  - (4) casing PVC 44' - 39' (material) (depth)  
 2" (size) If telescope see back.
  - (5) screen 5' 44' - 39' (length) (depth to top)  
 2" PVC (size) (material)
  - (6) pump 1 HP 18 (HP) (yield gpm)  
 ELECTRIC (type power)
  - (7) electric log No (yes or no)
  - (organization running log)
  - (8) how well bottom plugged Float Ball

DRILLERS REMARKS: Pump installed 15 Dec 1976  
 Had to wait on sprinkler system and Florist to build Christmas Garden


RECEIVED

JAN 20 1977

MISS. BD. OF WATER COMM

If well telescopes please sketch and show depths.

**GROUND LEVEL**

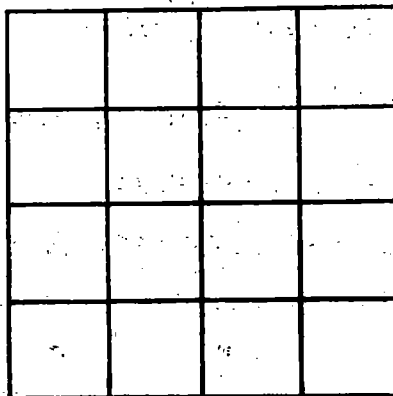

**SECTION** \_\_\_\_\_

Please indicate well location X.

**ADDITIONAL INFORMATION**

---

---

If more than one screen, show locations of each on sketch.