

Jackson
 W 2024
 Oct. 1, 1976

MISSISSIPPI
 BOARD OF WATER COMMISSIONERS
 416 North State Street
 Jackson, Mississippi 39201

WATER WELL DRILLERS LOG

Oct 1 1976 Bryant Well Co. JACKSON
 date well completed firm name county well located

LANDOWNER: Ernest H. Nurdell
6001 ST. MARTIN Rd.
N. Biloxi No. 39537
 (mailing address)

WELL LOCATION:
 sec. 15 T. 2 N. R. 9 E.
1 miles N of Biloxi
 (distance) (direction) (nearest town)

WELL PURPOSE: HOME
 (home, irrigation, municipal, industrial)

WELL COMPLETION DATA:

(1) diameter (inches) 2"

(2) total depth (feet) 301

(3) static water level (feet) 21 ^{below}/_{above} top of ground.

(4) casing PVC, 296,
 (material) (depth)

 If telescope see back.
 (size)

(5) screen 5", 301
 (length) (depth to top)
009, PVC
 (size) (material)

(6) pump 1 HP 10
 (HP) (yield gpm)
FLCET
 (type power)

(7) electric log No
 (yes or no)

 (organization running log)

(8) how well bottom plugged metal
SAVED


description of formations encountered	from	to
clay	0	24
sand	24	33
Blue Clay	33	53
fine sand	53	56
white clay	56	89
white sand	89	215
clay	215	223
fine sand	223	239
clay	239	271
good sand	271	301

RECEIVED
 DEC 6 1976
 MISS. BB. OF WATER COMM

DRILLERS REMARKS: ✓

If well telescopes please sketch and show depths.

GROUND LEVEL

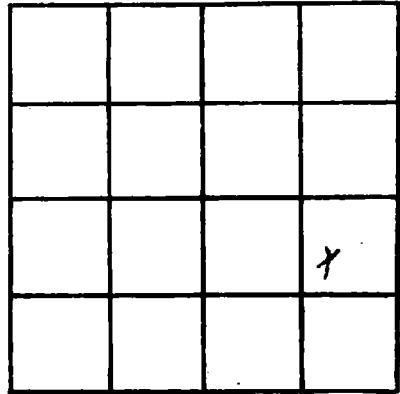

SECTION 15

Please indicate well location X.

ADDITIONAL INFORMATION

If more than one screen, show locations of each on sketch.