

Jackson
N 7030
December 4,
1976

MISSISSIPPI
 BOARD OF WATER COMMISSIONERS
 416 North State Street
 135 Jackson, Mississippi 39201

WATER WELL DRILLERS LOG

Dec 4 1976 Bryant Well Co. JACKSON Co.
 date well completed firm name county well located


LANDOWNER: <u>J.E. PARKER</u>	description of formations encountered	from	to
<u>903 BRITANNY AVE.</u>			
<u>North Biloxi MS.</u> (mailing address)	<u>Clay</u>	<u>0</u>	<u>29</u>
	<u>White sand</u>	<u>29</u>	<u>44</u>
	<u>Blue clay</u>	<u>44</u>	<u>70</u>
	<u>sand</u>	<u>70</u>	<u>90</u>
	<u>Clay</u>	<u>90</u>	<u>107</u>
	<u>sand</u>	<u>107</u>	<u>112</u>
	<u>Clay</u>	<u>112</u>	<u>118</u>
	<u>Red</u>	<u>118</u>	<u>139</u>
	<u>Clay</u>	<u>139</u>	<u>192</u>
	<u>sand</u>	<u>192</u>	<u>201</u>
	<u>Clay</u>	<u>201</u>	<u>243</u>
	<u>sand</u>	<u>243</u>	<u>249</u>
	<u>Clay</u>	<u>249</u>	<u>253</u>
	<u>sand, sand</u>	<u>253</u>	<u>279</u>
WELL LOCATION: sec. <u>15</u> T. <u>7</u> N. R. <u>9</u> E <u>1</u> miles <u>N</u> of <u>Biloxi</u> (distance) (direction) (nearest town)			
WELL PURPOSE: <u>HOME</u> (home, irrigation, municipal, industrial)			
WELL COMPLETION DATA: (1) diameter (inches) <u>2"</u> (2) total depth (feet) <u>279'</u> (3) static water level (feet) <u>21</u> ^{below} _{above} top of ground. (4) casing <u>PVC</u> , <u>279</u> , (material) (depth) _____ If telescope see back. (size) (5) screen <u>5"</u> , <u>274'</u> (length) (depth to top) <u>009</u> , <u>PVC</u> (size) (material) (6) pump <u>1</u> <u>10</u> (HP) (yield gpm) <u>ELECT</u> (type power) (7) electric log <u>No</u> (yes or no) _____ (organization running log) (8) how well bottom plugged <u>Metal</u> <u>SAND SHAK</u>			
DRILLERS REMARKS:			

RECEIVED
 DEC 18 1976

MISS. BD. OF WATER COMMISSIONERS

If well telescopes please sketch and show depths.

GROUND LEVEL

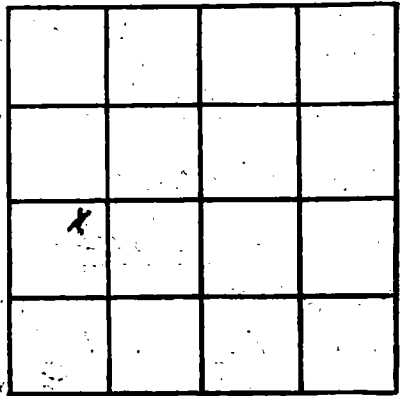

SECTION 15

Please indicate well location X.

ADDITIONAL INFORMATION

If more than one screen, show locations of each on sketch.