

JACKSON  
 N 2035  
 4/30/77

MISSISSIPPI  
 BOARD OF WATER COMMISSIONERS  
 416 North State Street  
 135 Jackson, Mississippi 39201

WATER WELL DRILLERS LOG

4/30/77 date well completed  
 Central Drilling firm name  
 Jackson county well located

LANDOWNER: J.A. Kneuman

description of formations encountered

from to

1000/ Shoh pine Dr  
 Ocean Springs, Miss  
 (mailing address)

top soil	1	3
Red Clay	3	18
white sand	18	60
clay	60	65
White Sand	65	90
Sugar Sand	90	120
Soft Blue Clay	120	200
fine water sand	200	230
hard Blue Clay	230	295
fine water sand	295	315
Dark water sand	315	335

WELL LOCATION:

sec. 10 T 7 N R 9 E  
 S W  
 2 1/2 miles W of Gulf Hill  
 (distance) (direction) (nearest town)

WELL PURPOSE: home  
 (home, irrigation, municipal, industrial)

WELL COMPLETION DATA:

- (1) diameter (inches) 2"
- (2) total depth (feet) 335
- (3) static water level (feet) 60 <sup>below</sup>/<sub>above</sub> top of ground
- (4) casing PVC, 325  
 (material) (depth)  
 (size) If telescope see back.
- (5) screen 10, 325  
 (length) (depth to, top)  
 2" PVC  
 (size) (material)
- (6) pump One 12  
 (HP) (yield gpm)  
 Elec  
 (type power)
- (7) electric log No  
 (yes or no)

(organization running log)

(8) how well bottom plugged  
 2' hard water table


DRILLERS REMARKS:  
 none

RECEIVED  
 JUN 28 1977

MISS. RD. OF WATER COMM.

If well telescopes please sketch and show depths.

GROUND LEVEL

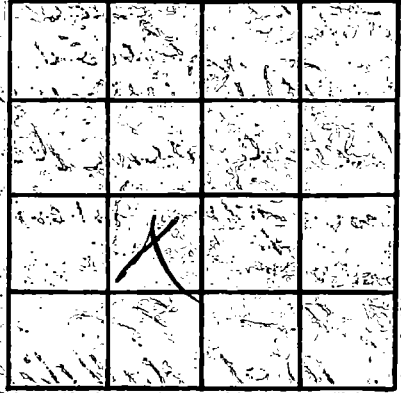

SECTION \_\_\_\_\_

Please indicate well location X.

ADDITIONAL INFORMATION

If more than one screen, show locations of each on sketch.