

JACKSON

MISSISSIPPI  
BOARD OF WATER COMMISSIONERS  
416 North State Street  
Jackson, Mississippi 39201

WATER WELL DRILLERS LOG

JACKSON

HARRISON  
N 2042  
7/22/77

July 22 1977  
date well completed

M. McKie Well Works, Inc.  
firm name

Harrison  
county well located

LANDOWNER: Betty Breal?

etzel Hughes  
Rt. 3, Box 172

Biloxi, Mo.

(mailing address)

WELL LOCATION:

sec. 1 T 7 N R 9 E  
6 miles SE of Latimer  
(distance) (direction) (nearest town)

description of formations encountered

from to

clay	0	38
sand	38	65
blue clay	65	187
slush	187	252
coarse sand	252	264
blue clay	264	357
fine sand	357	378
coarse sand	378	400

WELL PURPOSE:

(home) irrigation, municipal, industrial

WELL COMPLETION DATA:

- (1) diameter (inches) 2"
- (2) total depth (feet) 400'
- (3) static water level (feet) 60' below top of ground
- (4) casing PVC 40' 390' (material) (depth)
- (size) If telescope see back.
- (5) screen 10' (length) (depth to top)
- 2" plastic (size) (material)
- (6) pump 1 (HP) 10 (yield gpm)
- electric (type power)
- (7) electric log no (yes or no)
- (organization running log)
- (8) how well bottom plugged sand shark


RECEIVED  
NOV 25 1977

MISS. BD. OF WATER COMM

DRILLERS REMARKS:

If well telescopes please sketch and show depths.

GROUND LEVEL

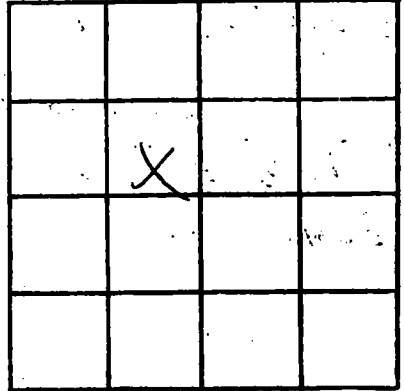

SECTION 1

Please indicate well location X.

ADDITIONAL INFORMATION

If more than one screen, show locations of each on sketch.