

Jackson  
 N 2044  
 8/9/77

MISSISSIPPI  
 BOARD OF WATER COMMISSIONERS  
 416 North State Street  
 Jackson, Mississippi 39201

WATER WELL DRILLERS LOG

8-9 1977 Const Water Well Sew. Jackson  
 date well completed firm name county well located

#1  
 LANDOWNER Jackson County  
 Develops  
 (mailing address)

WELL LOCATION:  
 sec. 7 T. 7 R. 8  
 1 1/2 miles North of Ocean Springs  
 (distance) (direction) (nearest town)

WELL PURPOSE:  
 (home, irrigation, municipal, industrial)

WELL COMPLETION DATA:  
 (1) diameter (inches) 4" x 2"  
 (2) total depth (feet) 397'  
 (3) static water level (feet) 60' below top of ground.  
 (4) casing PVC 387' (material) (depth)  
 4 x 2 (size) if telescope see back.  
 (5) screen 10' 387' (length) (depth to top)  
 2" PVC (size) (material)  
 (6) pump 1 hp 20 (type) (yield gpm)  
 Electric (type power)  
 (7) electric log No (yes or no)  
 (organization running log)

(8) how well bottom plugged  
 Pack wash value


description of formations encountered	from	to
Top soil sand	0	3
Red clay	3	15
Blue Clay	15	31
Sand (m)	31	97
Blue Clay	97	326
Sand (m)	326	344
Blue Clay	344	380
Sand (mc)	380	397

RECEIVED  
 JAN - 9 1978

DRILLERS REMARKS:

If well telescopes please sketch and show depths.

GROUND LEVEL

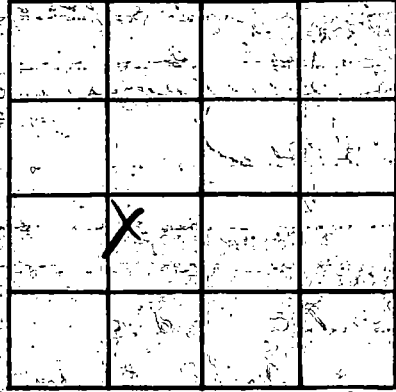

SECTION 7

Please indicate well location X.

ADDITIONAL INFORMATION

If more than one screen, show locations of each on sketch.