

Jackson
 N 2047
 9/10/77

MISSISSIPPI
 BOARD OF WATER COMMISSIONERS
 416 North State Street
 Jackson, Mississippi 39201

WATER WELL DRILLERS LOG

9/10/77 date well completed
 Coastal Drilling firm name
 Jackson county well located

LANDOWNER: C.B. Thompson
 13805 Meridale Dr.
 Ocean Springs, Miss.
 (mailing address)

description of formations encountered	from	to
top soil	1	3
Red Clay	3	12
Coarse white sand	12	45
Super sand	45	60
5 ft blue clay	60	290
Rock	290	292
fine white sand	292	305
hard blue clay	305	320
fine to good water sand	320	370

WELL LOCATION:
 sec. 1 T. 7 N. R. 9 E
 13.3 miles NE Gulf Hill
 (distance) (direction) (nearest town)

WELL PURPOSE: home
 (home, irrigation, municipal, industrial)

WELL COMPLETION DATA:
 (1) diameter (inches) 2"
 (2) total depth (feet) 350'
 (3) static water level (feet) 25' ^{below} top of ground
 (4) casing pipe 340'
 (material) (depth)
 (size) if telescope see back.
 (5) screen 10' 340'
 (length) (depth to top)
 7" pipe
 (size) (material)
 (6) pump One 8
 (HP) (yield gpm)
 Cle
 (type power)
 (7) electric log no
 (yes or no)
 (organization running log)


(8) how well bottom plugged
 Drilled with John
 DRILLERS REMARKS:

RECEIVED
 JAN 9 1978

MISS. BD. OF WATER COMM

If well telescopes please sketch and show depths.

GROUND LEVEL

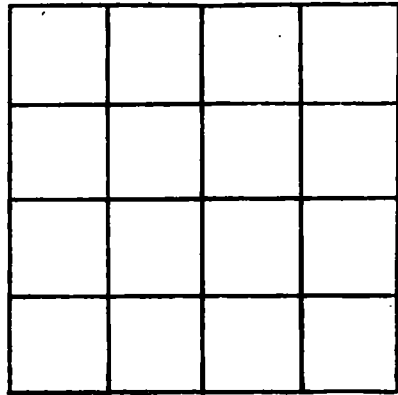

SECTION _____

Please indicate well location X.

ADDITIONAL INFORMATION

If more than one screen, show locations of each on sketch.