

Jackson
 N 2049
 10/5/77

MISSISSIPPI
 BOARD OF WATER COMMISSIONERS
 416 North State Street
 Jackson, Mississippi 39201

WATER WELL DRILLERS LOG

10-5 1977 Coast Water Well Sew. Jackson
 date well completed firm name county well located

LANDOWNER Edward Radel
 P.O. Box 99
 Ocean Springs, Miss. 39564
 (mailing address)

description of formations encountered	from	to
Top soil	0	12
Med sand	12	20

WELL LOCATION:
 sec 34 T 7 R 8
 4 miles East of Ocean Springs
 (distance) (direction) (nearest town)

blue clay + Shell	20	40
Med. sand	40	55
blue clay	55	60

WELL PURPOSE: Home
 (home, irrigation, municipal, industrial)

Coarse sand	60	80
-------------	----	----

WELL COMPLETION DATA:
 (1) diameter (inches) 2"
 (2) total depth (feet) 520'
 (3) static water level (feet) 50' below top of ground
 (4) casing P.V.C. 510' (material) (depth)
 2" (size) if telescope see back.
 (5) screen 10' 510' (length) (depth to top)
 2" (size) P.V.C. (material)
 (6) pump 1 H.P. 8 (HP) (yield gpm)
 Elec. (type power)
 (7) electric log No (yes or no)
 (organization running log)

blue clay	80	100
Med sand	100	135
blue clay	135	456
fine to coarse sand	456	520

(8) How well bottom plugged
 Back wash valve


DRILLERS REMARKS:

RECEIVED
 JAN 17 1978

MISS. BD. OF WATER COMM

If well telescopes please sketch and show depths.

GROUND LEVEL

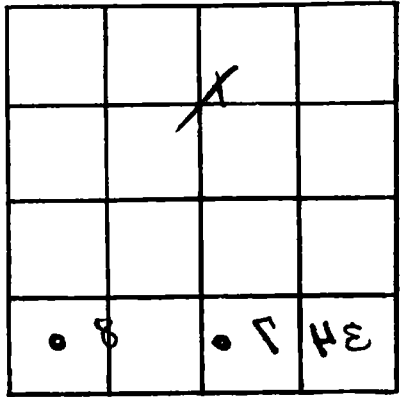

SECTION 34

Please indicate well location X.

ADDITIONAL INFORMATION

8

If more than one screen, show locations of each on sketch.