

JACKSON

N 2058

MISSISSIPPI
 BOARD OF WATER COMMISSIONERS
 416 North State Street
 Jackson, Mississippi 39201

WATER WELL DRILLERS LOG

2-16-1978 date well completed

78 Coast Water Well Sew. Inc. firm name

Jackson county well located

LANDOWNER: Anthony Mayfield

Box 785, Ocean Springs, Miss. (mailing address) 39564

description of formations encountered	from	to
Top soil	0	6
Red Clay	6	26
Sand	26	30
Blue Clay	30	130
Sand (h-c)	130	170

WELL LOCATION:

sec. 7-T-7 R. 8-W

1 1/2 miles North of Ocean Springs (distance) (direction) (nearest town)

WELL PURPOSE: home (home, irrigation, municipal, industrial)

WELL COMPLETION DATA:

(1) diameter (inches) 170'

(2) total depth (feet)

(3) static water level (feet) 25' below top of ground

(4) casing P.V.C. 160' (material) (depth)

2" If telescope see back. (size)

(5) screen 10' 160' (length) (depth to top)

2" P.V.C. (size) (material)

(6) pump 1 H.P. 8- (HP) (yield gpm)

Elec. (type power)

(7) electric log 4/0- (yes or no)

(organization running log)

(8) how well bottom plugged Backwash Valve

DRILLERS REMARKS:


RECEIVED

MAY 30 1978

MISS. BD. OF WATER COMM

If well telescopes please sketch and show depths.

GROUND LEVEL

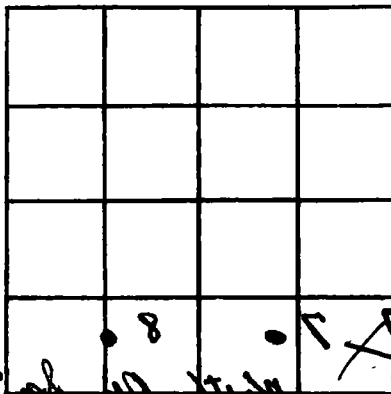

SECTION 2

Please indicate well location X.

ADDITIONAL INFORMATION

If more than one screen, show locations of each on sketch.