

Jackson  
 N 2063  
 8/8/77

MISSISSIPPI  
 BOARD OF WATER COMMISSIONERS  
 416 North State Street  
 Jackson, Mississippi 39201

WATER WELL DRILLERS LOG

8/8/77 19 Coastal Drilling Jackson  
 date well completed firm name county well located  
Bilalji, Miss

LANDOWNER: L.H. Bond  
Cook Rd  
Bilalji, Miss  
 (mailing address)

WELL LOCATION:  
 sec. 11 T. 2 N. R. 9 E  
2 1/2 miles NW Sheep Hill  
 (distance) (direction) (nearest town)

WELL PURPOSE: home  
 (home, irrigation, municipal, industrial)

WELL COMPLETION DATA:  
 (1) diameter (inches) 4 1/2"  
 (2) total depth (feet) 465'  
 (3) static water level (feet) 60' <sup>below</sup> above top of ground.  
 (4) casing PVC, 450'  
 (material) (depth)  
4 1/2" If telescope see back.  
 (size)  
 (5) screen 15', 450'  
 (length) (depth to top)  
2", PVC  
 (size) (material)  
 (6) pump one sh, 70  
 (HP) (yield gpm)  
3 hp  
 (type power)  
 (7) electric log no  
 (yes or no)  
 (organization running log)

description of formations encountered	from	to
top soil	1	3
soft red clay	3	15
yellow sand	15	35
white sand	35	60
soft blue clay	60	230
fine water sand	230	260
soft blue clay	260	320
fine water sand & shell	320	345
hard blue clay	345	415
fine water sand	415	420
coarse water sand	420	465

(8) how well bottom plugged  
2" back wash pipe  
 DRILLERS REMARKS: B-19


RECEIVED  
 DEC 29 1977

MISS. BD. OF WATER COMM.

If well telescopes please sketch and show depths.

GROUND LEVEL

160' 4" PVC Casing

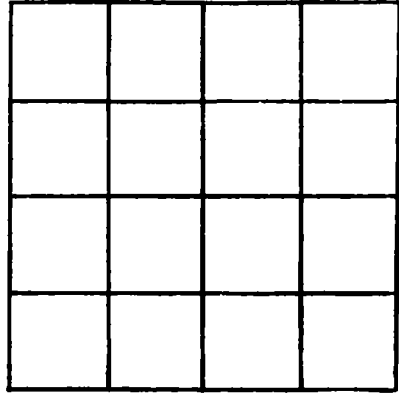

SECTION \_\_\_\_\_

Please indicate well location X.

ADDITIONAL INFORMATION

290' 2" PVC Casing

15' 2" PVC Screen

2" back wash valve

B-19

If more than one screen, show locations of each on sketch.