

JACKSON
N 7064

MISSISSIPPI
BOARD OF WATER COMMISSIONERS
416 North State Street
Jackson, Mississippi 39201

WATER WELL DRILLERS LOG
COASTAL DRILLING & SERVICE CO.

4-16-99
4/16/99
date well completed

ROUTE BOX 618
county well located

LANDOWNER: J. Morris
Old Hwy 90
Ocean Springs, Miss
(mailing address)

description of formations encountered	from	to
Top soil	1	3
Red Clay	3	15
White Sand	15	35
Soft Blue Clay	35	70
White Sand	70	85
Soft Blue Clay	85	160
Hard Blue Clay	160	265
Free water Sand	265	265
Good water Sand	265	260

WELL LOCATION:
sec. 11 T 7 N R 9 E
2 1/2 mi SW of Hill
(distance) (direction) (nearest town)

WELL PURPOSE: home
(home, irrigation, municipal, industrial)


- WELL COMPLETION DATA:
- (1) diameter (inches) 24
 - (2) total depth (feet) 260'
 - (3) static water level (feet) 35' below top of ground
 - (4) casing PVC, 250' (depth)
 - (size) If telescope see back.
 - (5) screen 10', 250' (length) (depth to top)
 - 24" (size), PVC (material)
 - (6) pump one 14 (HP) (yield gpm)
 - 1/2 hp (type power)
 - (7) electric log no (yes or no)
 - (organization running log)

(8) how well bottom plugged
2' back wash valve
DRILLERS REMARKS: 19-B

DEPT. OF NATURAL RESOURCES
BUREAU OF LAND & WATER RESOURCES
JAN 14 1980
RECEIVED

If well telescopes please sketch and show depths.

GROUND LEVEL

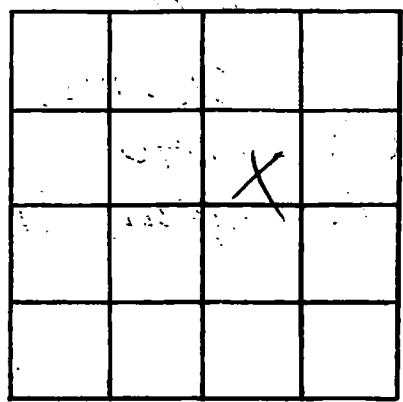

SECTION _____

Please indicate well location X.

ADDITIONAL INFORMATION

Lined area for additional information.

If more than one screen, show locations of each on sketch.