

JACKSON

N 2070

MISSISSIPPI
 BOARD OF WATER COMMISSIONERS
 416 North State Street
 Jackson, Mississippi 39201

WATER WELL DRILLERS LOG

6-2-1978 date well completed
 28 Coast Water Well Serv., Inc. firm name
 Jackson county well located

LANDOWNER: Jack Osborne

description of formations encountered

from to

6913 Bayou Pine Dr.

Top soil

0 4

Biloxi, Miss. 39532
(mailing address)

Red Clay

4 10

WELL LOCATION:

Blue Clay

10 23

sec 13 T 7 R 9
 1 1/2 miles W.W. of Ocean Springs
 (distance) (direction) (nearest town)

White Coarse sand

23 44

WELL PURPOSE: Home
(home, irrigation, municipal, industrial)

Blue clay

44 191

WELL COMPLETION DATA:

Blue fine sand

191 210

- (1) diameter (inches) 2
- (2) total depth (feet) 455
- (3) static water level (feet) 45 ^{below} _{above} top of ground.
- (4) casing P.V.C. 445' (material) (depth)

Blue Clay

210 398

2" (size) If telescope see back.

Gray med. sand

398 404

- (5) screen 10' (length) 445' (depth to top)

Gray Coarse sand

404 455

2" (size) P.V.C. (material)

- (6) pump 1/2 h.p. 8 (HP) (yield gpm)

Elec. (type power)

- (7) electric log 46. (yes or no)

(organization running log)

- (8) how well bottom plugged Back Wash Valve

RECEIVED


AUG - 4 1978

DRILLERS REMARKS:

MISS. BD. OF WATER COMM

If well telescopes please sketch and show depths.

GROUND LEVEL

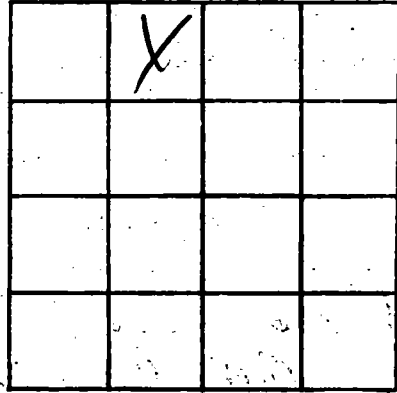

SECTION 13

Please indicate well location X.

ADDITIONAL INFORMATION

If more than one screen, show locations of each on sketch.