

JACKSON

N 2011

MISSISSIPPI BOARD OF WATER COMMISSIONERS 416 North State Street Jackson, Mississippi 39201

WATER WELL DRILLERS LOG

5/13/78 date well completed Coastal Drilling Serv. firm name Jackson county well located

Table with 4 columns: LANDOWNER, description of formations encountered, from, to. Includes entries for 'Top Soil', 'Clay Clay', 'Sugar Sand', etc.

WELL LOCATION: sec. 7 T. 9 N. R. 8 E. 1/2 miles North Gulf Hill (distance) (direction) (nearest town)


WELL PURPOSE: home (home, irrigation, municipal, industrial)

WELL COMPLETION DATA:

- (1) diameter (inches) 2"
(2) total depth (feet) 370'
(3) static water level (feet) 65 below top of ground.
(4) casing PVC 360' (material) (depth)
(5) screen 10' 360' (length) (depth to top)
(6) pump One 10 (HP) (yield gpm)
(7) electric log no (yes or no)
(organization running log)

(8) how well bottom plugged 2nd hard work table

DRILLERS REMARKS:

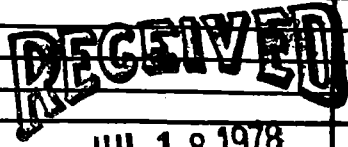

JUL 18 1978

MISS. BD. OF WATER COMM

If well telescopes please sketch and show depths.

GROUND LEVEL

			X

SECTION

Please indicate well location X.

ADDITIONAL INFORMATION

If more than one screen, show locations of each on sketch.