

JACKSON
 N 2028
 10-20-78

MISSISSIPPI
 BOARD OF WATER COMMISSIONERS
 416 North State Street
 Jackson, Mississippi 39201

WATER WELL DRILLERS LOG

10-20-1978 date well completed
 78 Cashwater Well Service, Inc. firm name
 Jackson county well located

LANDOWNER: C. B. Hubbert

description of formations encountered

from to

Phlo- 1001 Robinson Street Clear Springs, Miss. (mailing address)	0-15 15-26 26-30 30-90 90-160	15 26 30 90 160	15 26 30 90 160
	Red Top soil + Red Clay		
	Red fine sand		
	Red Clay		
	Red Coarse sand		
	Blue Clay		

WELL LOCATION:
 sec. 8 T. 7 R. 8
 7 miles East of Clear Springs
 (distance) (direction) (nearest town)

WELL PURPOSE: Home
 (home, irrigation, municipal, industrial)


WELL COMPLETION DATA:

- (1) diameter (inches) 2"
- (2) total depth (feet) 327'
- (3) static water level (feet) 34' below top of ground
- (4) casing PVC, 317' (depth)
 2" (size) if telescope see back.
- (5) screen 10' (length), 317' (depth to top)
 2" (size), PVC (material)
- (6) pump 1/2 hp, 5.8 (yield gpm)
 Elec (type power)
- (7) electric log No (yes or no)

160-229	Blue Clay	229	313
313-327	Gray med sand	313	327

(8) how well bottom plugged
 back wash valve

DRILLERS REMARKS:

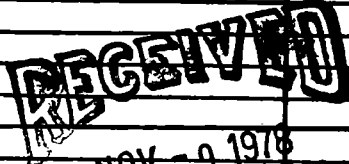

NOV - 9 1978

MISS. BB. OF WATER COMMISSIONERS

