

JACKSON
 12092
 11/29/78

MISSISSIPPI
 BOARD OF WATER COMMISSIONERS
 416 North State Street
 Jackson, Mississippi 39201

WATER WELL DRILLERS LOG

11-29-1978 date well completed
 McNeil well work firm name
 Jackson county well located

LANDOWNER: Michael Freeman

Rt. 3 Box 310

Ocean Springs, MS
 (mailing address)

WELL LOCATION:

sec. 8 T. 7 N R. 8 E
 4 miles N of Ocean Springs
 (distance) (direction) (nearest town)

WELL PURPOSE: home
 (home, irrigation, municipal, industrial)

WELL COMPLETION DATA:

- (1) diameter (inches) 2"
- (2) total depth (feet) 670'
- (3) static water level (feet) 15' below top of ground
- (4) casing PVC 660' (material) (depth)
 (size) If telescope see back.
- (5) screen 10' (length) (depth to top)
 2" (size) plastic (material)
- (6) pump 1 (HP) 18 (yield gpm)
 electric (type power)
- (7) electric log no (yes or no)
 (organization running log)
- (8) how well bottom plugged sand
 Shark

description of formations encountered

from to

clay	0	45
y. sand	45	110
b. clay	110	281
y. sand	281	314
clay	314	357
y. sand	357	388
b. clay	388	432
clay	432	471
b. clay	471	520
b. sand	520	560
b. clay	560	631
c. sand	631	670

DRILLERS REMARKS:


Miss. Board of Water Comm.

APR 6 - 1979

RECEIVED

If well telescopes please sketch and show depths.

GROUND LEVEL

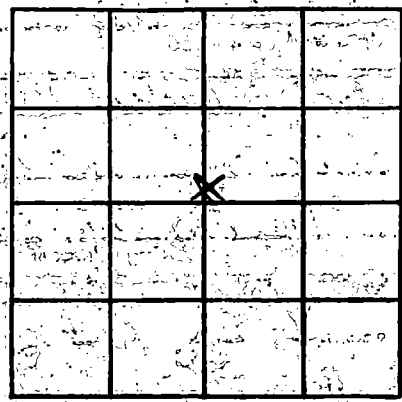

SECTION _____

Please indicate well location X.

ADDITIONAL INFORMATION

If more than one screen; show locations of each on sketch.