

JACKSON
 N 2100
 4-18-79

MISSISSIPPI
 BOARD OF WATER COMMISSIONERS
 416 North State Street
 Jackson, Mississippi 39201

WATER WELL DRILLERS LOG

4-18-79 19 Coast Water Well Serv. Inc. Jackson
 date well completed firm name county well located

LANDOWNER	description of formations encountered	from	to
<u>John Adams, Jr.</u>	<u>Top soil</u>	<u>0</u>	<u>10</u>
<u>2840 Eagle Pine Dr.</u>	<u>Blue Clay</u>	<u>10</u>	<u>44</u>
<u>Ocean Springs, Miss</u>	<u>Gray coarse sand + gravel</u>	<u>44</u>	<u>92</u>
(mailing address)	<u>Blue Clay</u>	<u>92</u>	<u>130</u>
WELL LOCATION:	<u>Gray coarse sand</u>	<u>130</u>	<u>162</u>
sec. <u>35</u> T <u>7</u> R <u>8</u>	<u>Blue Clay</u>	<u>162</u>	<u>310</u>
<u>2</u> miles <u>East</u> of <u>Ocean Springs</u>	<u>Blue Clay & streak of sand</u>	<u>310</u>	<u>415</u>
(distance) (direction) (nearest town)	<u>Gray fine sand</u>	<u>415</u>	<u>449</u>
WELL PURPOSE: <u>None</u>	<u>Blue Clay</u>	<u>449</u>	<u>490</u>
(home, irrigation, municipal, industrial)	<u>Gray fine sand</u>	<u>490</u>	<u>520</u>
WELL COMPLETION DATA:	<u>Blue Clay</u>	<u>520</u>	<u>570</u>
(1) diameter (inches) <u>2"</u>	<u>Gray fine sand</u>	<u>570</u>	<u>599</u>
(2) total depth (feet) <u>993</u>	<u>Blue Clay + clam shell</u>	<u>599</u>	<u>726</u>
(3) static water level (feet) <u>13'</u> below top of ground	<u>Rock</u>	<u>726</u>	
(4) casing <u>PVC</u> , <u>993</u> (material) (depth)	<u>Blue Clay</u>	<u>726</u>	<u>795</u>
<u>2"</u> (size) if telescope see back.	<u>Blue Clay & streak of sand</u>	<u>795</u>	<u>820</u>
(5) screen <u>20'</u> , <u>993'</u> (length) (depth to top)	<u>Blue Clay</u>	<u>820</u>	<u>903</u>
<u>2"</u> (size) <u>PVC</u> (material)	<u>Gray coarse sand</u>	<u>903</u>	<u>993</u>
(6) pump <u>1</u> (HP) <u>10</u> (yield gpm)			
(type power)			
(7) electric log <u>No</u> (yes or no)			
(organization running log)			
(8) How well bottom plugged <u>Back Wash Valve</u>			


DRILLERS REMARKS:

MAY 29 1979

RECEIVED

If well telescopes please sketch and show depths.

GROUND LEVEL

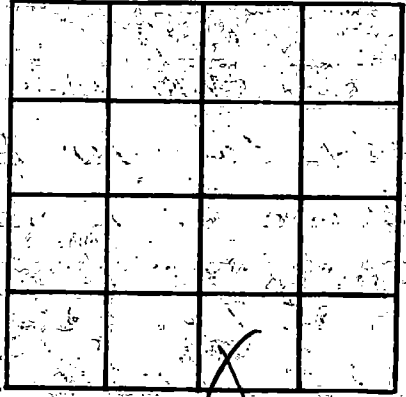

SECTION 35

Please indicate well location X.

ADDITIONAL INFORMATION

If more than one screen, show locations of each on sketch.