

JACKSON
N 2103
1-23-79

MISSISSIPPI
BOARD OF WATER COMMISSIONERS
416 North State Street
Jackson, Mississippi 39201

WATER WELL DRILLERS LOG

1-23-1979 date well completed
Coast Water Well Serv. Inc. firm name
Jackson county well located

LANDOWNER	description of formations encountered	from	to
Spring Hill Lp. Co. Worsham Land Trailer Town Jct 456	Sandy Top soil	0	5
Ocean Springs Miss. (mailing address) 39564	gray clay	5	25
	Sand (C)	25	35
	Blue Clay	35	58
	Sand (C)	58	75
	Blue Clay	75	150
	Sand (F)	150	178
	Blue Clay	178	295
	Sand (m)	295	315
	Blue Clay	315	380
	Sand (m)	380	420
	Blue Clay	420	468
	Sand (m)	468	510

WELL LOCATION:

sec 25 T 7 R 8
2 1/2 miles East of Ocean Springs
(distance) (direction) (nearest town)

WELL PURPOSE: Municipal
(home, irrigation, municipal, industrial)

WELL COMPLETION DATA:

- (1) diameter (inches) 2"
- (2) total depth (feet) 510'
- (3) static water level (feet) 45' (about top of ground)
- (4) casing PVC 500' (material) (depth)
2" (size) if telescope see back.
- (5) screen 10' 500' (length) (depth to top)
2" PVC (size) (material)
- (6) pump 1 h.p. 8 (HP) (yield gpm)
Elect (type power)
- (7) electric log No. (yes or no)

(organization running log)

(8) how well bottom plugged
Pack Wash Valve

DRILLERS REMARKS:


Miss. Board of Water Comm.

MAY 30 1979

RECEIVED

If well telescopes please sketch and show depths.

GROUND LEVEL

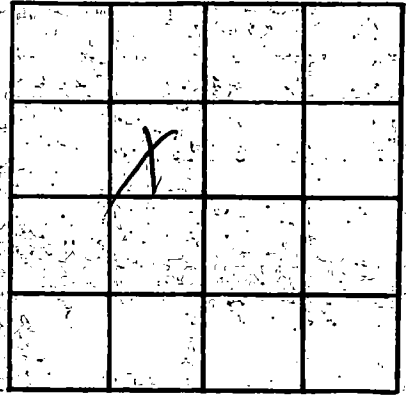

SECTION 25

Please indicate well location X.

ADDITIONAL INFORMATION

If more than one screen,
show locations of each on sketch.